

MISSISSIPPI DEPARTMENT OF NATURAL RESOURCES

Bureau of Land and Water Resources

Southport Mall

P.O. Box 10631

Jackson, Mississippi 39209

WATER WELL DRILLERS LOG

Jackson  
G 2093

10-21-89  
date well completed

Southwater well  
firm name

Jackson  
county well located

LANDOWNER:	description of formations encountered	from	to
Earle Halberg	sand	0	15
Awy 613 Big Point (mailing address)	Clay Sand	15 2.5	25 45
<b>WELL LOCATION:</b>			
sec <u>27</u> T <u>5</u> N R <u>6</u> E (distance) miles (direction) of <u>Amory</u> (nearest town)			
<b>WELL PURPOSE:</b> <u>none</u> (home, irrigation, municipal, industrial)			
<b>WELL COMPLETION DATA:</b>			
(1) diameter (inches) <u>2"</u>			
(2) total depth (feet) <u>45'</u>			
(3) static water level (feet) <u>20</u> <input checked="" type="radio"/> below <input type="radio"/> above top of ground.			
(4) casing <u>PVC</u> <u>40'</u> (material) (depth)			
(size) If telescope see back.			
(5) screen <u>5'</u> <u>40'</u> (length) (depth to top)			
(6) pump <u>2"</u> <u>PVC</u> (size) (material)			
(7) electric log <u>NO</u> (yes or no)			
(organization running log)			
(8) how well bottom plugged <u>BWV</u>			


RECEIVED  
DEC 18 1989

Department of Natural Resources  
Bureau of Land & Water Resources

DRILLERS REMARKS:

If well telescopes please sketch and show depths.

GROUND LEVEL

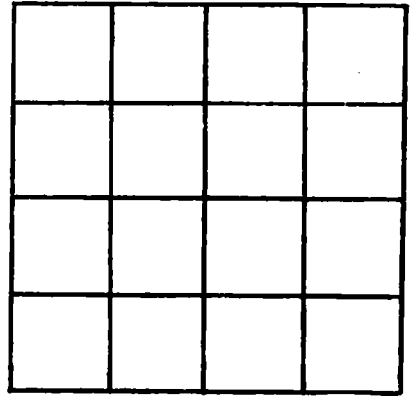

SECTION \_\_\_\_\_

Please indicate well location X.

ADDITIONAL INFORMATION

If more than one screen,  
show locations of each on sketch.