

MISSISSIPPI DEPARTMENT OF NATURAL RESOURCES

Bureau of Land and Water Resources

Southport, Miss.

P.O. Box 10831

RECEIVED

Jackson, Mississippi 39209

WATER WELL DRILLERS LOG 9 1990

Jackson
G 2096

4-1990
Date well completed


Southern Well Drilling
firm name

Department of Natural Resources
Bureau of Land & Water Resources

LANDOWNER: <u>Mr Emmons</u>	description of formations encountered	from	to
<u>Hwy 614</u> <u>Surlee</u> (mailing address)	<u>sandy soil</u> <u>clay</u> <u>sand</u>	0	20
		20	35
		35	55
WELL LOCATION:			
sec. <u>3</u> T <u>S</u> N R. <u>6</u> E			
<u>19</u> miles <u>N</u> of <u>Meridian</u>			
(distance) (direction) (nearest town)			
WELL PURPOSE: <u>Home</u>			
(home, irrigation, municipal, industrial)			
WELL COMPLETION DATA:			
(1) diameter (inches) <u>2"</u>			
(2) total depth (feet) <u>55'</u>			
(3) static water level (feet) <u>12</u> <u>below</u> <u>above</u> top of ground.			
(4) casing <u>PVC</u> <u>50'</u> (material) (depth)			
_____ if telescope see back. (size)			
(5) screen <u>5'</u> <u>50'</u> (length) (depth to top)			
<u>7"</u> <u>PVC</u> (size) (material)			
(6) pump <u>1</u> <u>12</u> (HP) (yield gpm)			
<u>AC</u> (type power)			
(7) electric log <u>No</u> (yes or no)			
_____ (organization running log)			
(8) how well bottom plugged <u>BWU</u>			
DRILLERS REMARKS:			

If well telescopes please sketch and show depths.

GROUND LEVEL

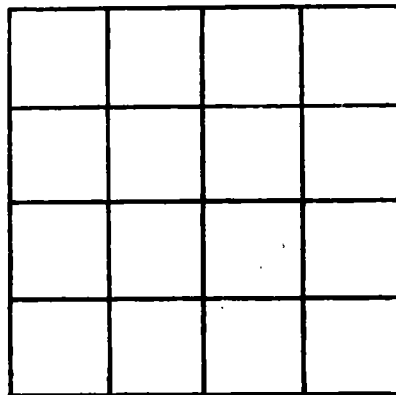

SECTION _____

Please indicate well location X.

ADDITIONAL INFORMATION

If more than one screen, show locations of each on sketch.