

MISSISSIPPI DEPARTMENT OF ENVIRONMENTAL QUALITY
Bureau of Land and Water Resources

P. O. Box 10631
Jackson, MS 39289-0631
WATER WELL DRILLERS LOG

COUNTY WELL LOCATED JACKSON	
WELL NUMBER G 2110	CODED
DATE WELL COMPLETED 3-3-92	

PERMIT NUMBER
NAME OF DRILLING FIRM Coast Water Well Dr Inc.

NAME & MAILING ADDRESS OF LANDOWNER Mary Goff			
WELL LOCATION: SEC <u>15</u> TOWNSHIP <u>5^N</u> RANGE <u>6^E</u>			
DISTANCE <u>2 1/2</u> Miles	DIRECTION <u>South</u>	NEAREST TOWN <u>Abbe</u>	
OTHER LANDMARK			
WELL PURPOSE <input checked="" type="checkbox"/> Home Irrigation, Municipal, Industrial, Fish Pond, etc.			

PUMP DATA		
PUMP TYPE (Circle One): Submersible, Turbine, Jet, Flowing Well, Other (Describe) _____		
POWER TYPE (Circle One): Electric, Tractor, Diesel, Gasoline, Butane, Other (Describe) _____		
Pump Capacity (GPM)	No. of Stages	Setting Depth _____ FT.
PUMP TEST		
Well yielded _____ GPM with		
a drawdown of _____ ft.		
after _____ hours of pumping		

WELL DATA		
Well Depth 50'	Casing Diameter (In.) 2"	Casing Length (Ft.) 45'
Type of Casing PVC	Hole Depth 50'	Depth to Static Water Level 25'
TYPE OF COMPLETION: (Circle One or More): Gravel Packed, Underreamed, Telescoped, Natural Development, Open Hole, Other (Describe) _____		
Top of Lap Pipe or Reduction in Casing FEET IF TELESCOPED OR MORE THAN ONE SCREEN: USE BACK PAGE		

LOG DATA	
TYPE OF LOG RUN (Circle One): Electric, Gamma Ray, Density, Sonic, Neutron, Other (Describe) _____	
Name of Organization Running Log	

SCREEN DATA		
Diameter - Inches 2"	Length - Feet 5'	Slot Size - Inches .008
Screen Type PVC	Depth to Bottom - Feet 50'	


GEOLOGIC DATA (Office Use Only)			
Surface Elev.	Geologic Unit	Unit Thickness	Depth to Top
Subs. SWL	Date	Analysis	Aquifer Test
Driller's Remarks			

DESCRIPTION OF FORMATIONS ENCOUNTERED	FROM	TO
Top soil	0	2
Red clay	2	12
Red sand	12	25
Blue clay	25	35
Coarse sand	35	50

FORMATIONS (Continued)	FROM	TO
RECEIVED		
MAR 23 1992		
Dept. of Environmental Quality Bureau of Land & Water Resources		
IF MORE SPACE IS NEEDED, USE BACK		

If well telescopes please sketch and show depths.

GROUND LEVEL

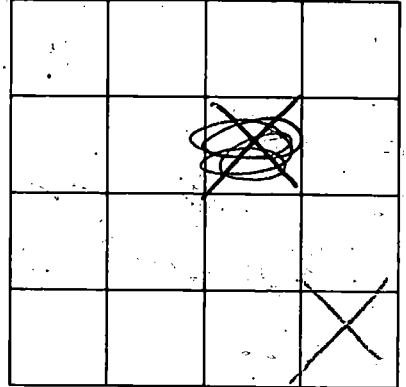

SECTION _____

Please indicate well location X.

ADDITIONAL INFORMATION

Lined area for additional information.

RECEIVED

STATION

THIS IS THE ONLY COPY OF THIS DOCUMENT TO BE USED

If more than one screen, show location of each on sketch.