

MISSISSIPPI DEPARTMENT OF ENVIRONMENTAL QUALITY
Bureau of Land and Water Resources

P. O. Box 10631
Jackson, MS 39289-0631
WATER WELL DRILLERS LOG

COUNTY WELL LOCATED
Jackson

WELL NUMBER CODED
G-2114

DATE WELL COMPLETED
9-9-92

PERMIT NUMBER

NAME OF DRILLING FIRM
Coast Water Well Serv. Inc.

NAME & MAILING ADDRESS OF LANDOWNER
James Jones

WELL LOCATION: SEC TOWNSHIP RANGE
12 5 N 6 E

DISTANCE DIRECTION NEAREST TOWN
2 Miles SE of Wake

OTHER LANDMARK

WELL PURPOSE: ~~Home~~ Irrigation, Municipal, Industrial, Fish Pond, etc.

PUMP DATA

PUMP TYPE (Circle One):
Submersible, Turbine, Jet, Flowing Well,
Other (Describe) _____

POWER TYPE (Circle One):
Electric, Tractor, Diesel, Gasoline, Butane,
Other (Describe) _____ H/P _____

Pump Capacity (GPM) No. of Stages Setting Depth _____ FT.

PUMP TEST

Well yielded _____ GPM with
a drawdown of _____ ft.
after _____ hours of pumping

WELL DATA

Well Depth <i>385'</i>	Casing Diameter (In.) <i>2"</i>	Casing Length (Ft.) <i>371'</i>
Type of Casing <i>PVC</i>	Hole Depth <i>385'</i>	Depth to Static Water Level <i>10'</i>

TYPE OF COMPLETION: (Circle One or More):
Gravel Packed, Underreamed, Telescoped,
Natural Development, Open Hole, Other

Top of Lap Pipe or Reduction in Casing

FEET IF TELESCOPED OR MORE THAN ONE SCREEN: USE BACK PAGE

LOG DATA

TYPE OF LOG RUN (Circle One): ~~No Log Run~~,
Electric, Gamma Ray, Density, Sonic, Neutron,
Other (Describe) _____

Name of Organization Running Log

SCREEN DATA

Diameter - Inches <i>2"</i>	Length - Feet <i>10'</i>	Slot Size - Inches <i>.008</i>
Screen Type <i>PVC</i>	Depth to Bottom - Feet <i>381</i>	

GEOLOGIC DATA (Office Use Only)

Surface Elev.	Geologic Unit	Unit Thickness	Depth to Top
Subs. SWL	Date	Analysis	Aquifer Test

Driller's Remarks

DESCRIPTION OF FORMATIONS ENCOUNTERED	FROM	TO	FORMATION ENCOUNTERED	FROM	TO
<i>TOP SOIL</i>	<i>0</i>	<i>2</i>			
<i>Gray yellow clay</i>	<i>2</i>	<i>40</i>			
<i>Coarse sand (hard)</i>	<i>40</i>	<i>90</i>			
<i>Blue Clay & sand</i>	<i>90</i>	<i>250</i>			
<i>Red sand</i>	<i>250</i>	<i>258</i>			
<i>Blue Clay & sand</i>	<i>258</i>	<i>340</i>			
<i>fine to coarse sand</i>	<i>340</i>	<i>385</i>			

RECEIVED


OCT 07 1992

Dept. of Environmental Quality
Bureau of Land & Water Resources

IF MORE SPACE IS NEEDED, USE BACK

If well telescopes please sketch and show depths:

GROUND LEVEL

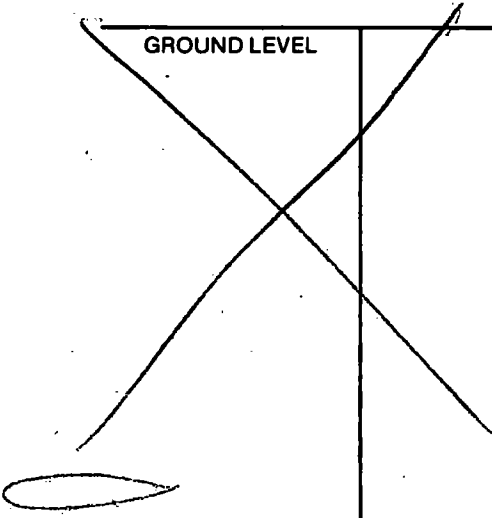

Handwritten notes around the table: '0 0 0 0 0 0' and '0 0 0 0' are written above the top two rows. '0 0 0 0' is written to the left of the second row. '32' is written in the second row, second column. '0' is written in the second row, fourth column. 'X' is drawn in the third row, second column. '0' is drawn in the third row, third column.

SECTION _____

Please indicate well location X.

ADDITIONAL INFORMATION

RECEIVED

NOV 19 1964

U.S. GEOLOGICAL SURVEY
WATER RESOURCES DIVISION
WASHINGTON, D.C. 20540

If more than one screen,
show location of each on sketch.