

MISSISSIPPI DEPARTMENT OF ENVIRONMENTAL QUALITY

Office of Land and Water Resources

P. O. Box 10631
Jackson, MS 39289-0631

WATER WELL DRILLERS LOG

COUNTY WELL LOCATED <i>Jackson</i>	
WELL NUMBER <i>RT 2117</i>	CODED
DATE WELL COMPLETED <i>4-29-93</i>	

PERMIT NUMBER
NAME OF DRILLING FIRM <i>Coastal Water Well Drilling, Inc.</i>

NAME & MAILING ADDRESS OF LANDOWNER #2 <i>Billie Johnson</i>			
WELL LOCATION: SEC <i>20</i> TOWNSHIP <i>5</i> RANGE <i>6</i>			
DISTANCE <i>6</i> Miles	DIRECTION <i>NE</i>	NEAREST TOWN <i>Van Cleve</i>	
OTHER LANDMARK			
WELL PURPOSE: Home, Irrigation, Municipal, Industrial, Fish Pond, etc. <i>Camp</i>			

PUMP DATA		
PUMP TYPE (Circle One): Submersible, Turbine, Jet, Flowing Well, Other (Describe)		
POWER TYPE (Circle One): Electric, Tractor, Diesel, Gasoline, Butane, Other (Describe) H/P		
Pump Capacity (GPM)	No. of Stages	Setting Depth FT.
PUMP TEST		
Well yielded _____ GPM with a drawdown of _____ ft. after _____ hours of pumping		

WELL DATA		
Well Depth <i>127'</i>	Casing Diameter (In.) <i>2"</i>	Casing Length (Ft.) <i>117'</i>
Type of Casing <i>PVC</i>	Hole Depth <i>130'</i>	Depth to Static Water Level <i>3'</i>

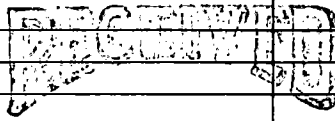
LOG DATA	
TYPE OF LOG RUN (Circle One): <i>No Log Run</i> , Electric, Gamma Ray, Density, Sonic, Neutron, Other (Describe)	
Name of Organization Running Log	

TYPE OF COMPLETION: (Circle One or More): <i>Gravel Packed</i> , Underreamed, Telescoped, <i>Natural Development</i> , Open Hole, Other			
WELL GROUTED TO A DEPTH OF <i>20</i> FEET Type Grout (circle one): Cement, <i>Bentonite</i> , or Mix			

GEOLOGIC DATA (Office Use Only)			
Surface Elev.	Geologic Unit	Unit Thickness	Depth to Top
Subs. SWL	Date	Analysis	Aquifer Test

SCREEN DATA		
Diameter - Inches <i>2"</i>	Length - Feet <i>10'</i>	Slot Size - Inches <i>.008</i>
Screen Type <i>PVC</i>	Depth to Bottom - Feet <i>127'</i>	

Driller's Remarks

DESCRIPTION OF FORMATIONS ENCOUNTERED	FROM	TO	FORMATIONS (Continued)	FROM	TO
<i>top soil</i>	<i>0</i>	<i>2</i>	 JUL 26 1993 Dept. of Environmental Quality Office of Land & Water Resources		
<i>gray clay</i>	<i>2</i>	<i>20</i>			
<i>coarse sand/gravel</i>	<i>20</i>	<i>45</i>			
<i>blue clay</i>	<i>45</i>	<i>95</i>			
<i>coarse sand</i>	<i>95</i>	<i>128</i>			
<i>blue clay</i>	<i>128</i>	<i>130</i>			

IF MORE SPACE IS NEEDED, USE BACK

If well telescopes please sketch and show depths.

GROUND LEVEL

		X	

SECTION 20

Please indicate well location X.

ADDITIONAL INFORMATION

If more than one screen, show location of each on sketch.