

**MISSISSIPPI DEPARTMENT OF ENVIRONMENTAL QUALITY**  
Bureau of Land and Water Resources

P. O. Box 10631  
Jackson, MS 39289-0631  
**WATER WELL DRILLERS LOG**

COUNTY WELL LOCATED <i>Jackson</i>	
WELL NUMBER <i>2-2118</i>	CODED
DATE WELL COMPLETED <i>6-11-93</i>	

PERMIT NUMBER
NAME OF DRILLING FIRM <i>Coast Water Well Serv Inc.</i>

NAME & MAILING ADDRESS OF LANDOWNER <i>Harold Baxter</i>			
WELL LOCATION: SEC <i>41</i> TOWNSHIP <i>5</i> RANGE <i>6</i>			
1 DISTANCE <i>5</i> Miles	DIRECTION <i>South</i> of	NEAREST TOWN <i>WAGE</i>	
OTHER LANDMARK			
WELL PURPOSE: <u>Home Irrigation</u> , Municipal, Industrial, Fish Pond, etc.			

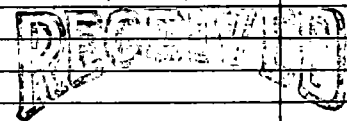
PUMP DATA			
PUMP TYPE (Circle One): Submersible, Turbine, Jet, Flowing Well, Other (Describe) _____			
POWER TYPE (Circle One): Electric, Tractor, Diesel, Gasoline, Butane, Other (Describe) _____ H/P _____			
Pump Capacity (GPM)	No. of Stages	Setting Depth _____ FT.	
PUMP TEST			
Well yielded _____ GPM with		a drawdown of _____ ft.	
after _____ hours of pumping			

WELL DATA		
Well Depth <i>165'</i>	Casing Diameter (In.) <i>2"</i>	Casing Length (Ft.) <i>155'</i>
Type of Casing <i>PVC</i>	Hole Depth <i>165'</i>	Depth to Static Water Level <i>21'</i>
TYPE OF COMPLETION: (Circle One or More): <u>Gravel Packed</u> , Underreamed, Telescoped, <u>Natural Development</u> , Open Hole, Other		
Top of Lap Pipe or Reduction in Casing _____ FEET		
IF TELESCOPED OR MORE THAN ONE SCREEN: USE BACK PAGE		

LOG DATA	
TYPE OF LOG RUN (Circle One): Electric, Gamma Ray, Density, Sonic, Neutron, Other (Describe) _____	
Name of Organization Running Log <i>No Log Run</i>	

SCREEN DATA		
Diameter - Inches <i>2"</i>	Length - Feet <i>10'</i>	Slot Size - Inches <i>.009</i>
Screen Type <i>PVC</i>	Depth to Bottom - Feet <i>165'</i>	

GEOLOGIC DATA (Office Use Only)			
Surface Elev.	Geologic Unit	Unit Thickness	Depth to Top
Subs. SWL	Date	Analysis	Aquifer Test
Driller's Remarks			

DESCRIPTION OF FORMATIONS ENCOUNTERED	FROM	TO	FORMATIONS (Continued)	FROM	TO
<i>top soil</i>	<i>0</i>	<i>8</i>	 <b>JUL 26 1993</b> Dept. of Environmental Quality Office of Land & Water Resources		
<i>thick coarse sand/gravel</i>	<i>8</i>	<i>70</i>			
<i>blue clay</i>	<i>70</i>	<i>110</i>			
<i>gray blue / s of sand</i>	<i>110</i>	<i>130</i>			
<i>light coarse sand</i>	<i>130</i>	<i>155</i>			
<i>thick coarse sand / clay</i>	<i>155</i>	<i>165</i>			
IF MORE SPACE IS NEEDED, USE BACK					

If well telescopes please  
sketch and show depths.

GROUND LEVEL

X			

SECTION 41

Please indicate well location X.

ADDITIONAL INFORMATION

If more than one screen,  
show location of each on sketch.