

MISSISSIPPI DEPARTMENT OF NATURAL RESOURCES

Bureau of Land and Water Resources

Southport Mall

P.O. Box 10631

Jackson, Mississippi 39209

WATER WELL DRILLERS LOG

Jackson
~~Greenville~~
 2100

5-8 1984 date well completed Perico Drilling Co firm name Jackson county well located

LANDOWNER: Jerry Lett

description of formations encountered

from

to

Vanclave Ms
 (mailing address)

Top soil	0	10
Sand	10	35
Clay	35	190
Good sand	190	210

WELL LOCATION:

sec. 36 T. 5 N R. 6 E
 9 miles West of Big Point
 (distance) (direction) (nearest town)

WELL PURPOSE:

(home) irrigation, municipal, industrial

WELL COMPLETION DATA:

- (1) diameter (inches) 2"
- (2) total depth (feet) 210'
- (3) static water level (feet) 60' below top of ground.
- (4) casing plastic, 200' (material) (depth)
- 0 (size) if telescope see back.
- (5) screen 10', 210' (length) (depth to top)
- 006, plastic (size) (material)
- (6) pump 1 (HP), 8 (yield gpm)
- Electric (type power)
- (7) electric log (yes or no)
- (organization running log)
- (8) how well bottom plugged BW

DEPT. OF NATURAL RESOURCES
 BUREAU OF LAND & WATER RESOURCES


JUN - 6 1984

RECEIVED

DRILLERS REMARKS:

If well telescopes please sketch and show depths.

GROUND LEVEL

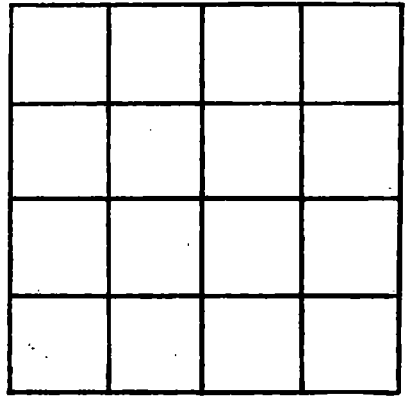

SECTION _____

Please indicate well location X.

ADDITIONAL INFORMATION

If more than one screen,
show locations of each on sketch.