

MISSISSIPPI DEPARTMENT OF NATURAL RESOURCES

Bureau of Land and Water Resources

Southport Mall

P.O. Box 10631

Jackson, Mississippi 39209

WATER WELL DRILLERS LOG

JACKSON
G 2123

9

10-15-1986 date well completed
86 Peice Drilling Co firm name
Jackson county well located

LANDOWNER: Jack Hamilton
Peice Rd.
Pascagoula, ms
(mailing address)

description of formations encountered	from to	
top soil	0	5
Clay	5	15
Sand & Clay	15	35
Good Sand	35	60

WELL LOCATION:
sec. 26 T. 5 N R. 6 E
1 miles South of 3-Rivers
(distance) (direction) (nearest town)

WELL PURPOSE:
(home irrigation, municipal, industrial)

WELL COMPLETION DATA:

(1) diameter (inches) 2"

(2) total depth (feet) 60'

(3) static water level (feet) 30' below above top of ground

(4) casing (material) plastic, (depth) 55'

0 (size) If telescope see back.

(5) screen (length) 5' (depth to top) 60'

1/2" (size) plastic (material)

(6) pump (HP) 1 (yield gpm) 12

electric (type power)

(7) electric log (yes or no)

(organization running log)

(8) how well bottom plugged BW

RECEIVED


SEP 15 1987

Department of Natural Resources
Bureau of Land & Water Resources

DRILLERS REMARKS:

If well telescopes please sketch and show depths.

GROUND LEVEL

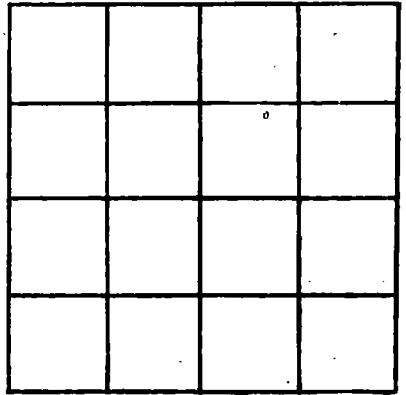

SECTION _____

Please indicate well location X.

ADDITIONAL INFORMATION

If more than one screen, show locations of each on sketch.