

Jackson Co

MISSISSIPPI BOARD OF WATER COMMISSIONERS
416 North State Street
Jackson, Mississippi 39201

E

WATER WELL DRILLERS LOG

JACKSON
5-12-85
62129

date well completed 5-12-1985 Pierce Drilling firm name Jackson county well located

LANDOWNER: James Emma

description of formations encountered	from	to
top soil	0	10
clay	10	35
good sand	35	65

Wade

Pascagoula, ms
(mailing address)

WELL LOCATION:

sec. 23 T. 5 N R. 6 E
7 miles southwest of Hurley
(distance) (direction) (nearest town)

WELL PURPOSE:

(home) Irrigation, municipal, industrial

WELL COMPLETION DATA:

- (1) diameter (inches) 2"
- (2) total depth (feet) 65'
- (3) static water level (feet) 10' below top of ground
- (4) casing plastic, 60' (material) (depth)
- (size) If telescope see back.
- (5) screen 5' length, 65' depth to top
- size material
- (6) pump 1 (HP) 10 (yield gpm)
- electric (type power)
- (7) electric log (yes or no)
- (organization running log)
- (8) how well bottom plugged BU


RECEIVED
JUL 23 1985

DRILLERS REMARKS:

Department of Natural Resources
Bureau of Land & Water Resources

If well telescopes please sketch and show depths.

GROUND LEVEL

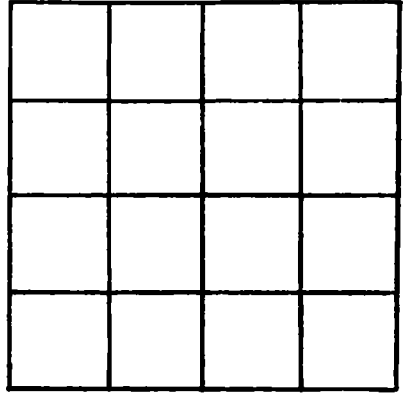

SECTION _____

Please indicate well location X.

ADDITIONAL INFORMATION

If more than one screen, show locations of each on sketch.