

MISSISSIPPI DEPARTMENT OF ENVIRONMENTAL QUALITY

Office of Land and Water Resources

P. O. Box 10631
Jackson, MS 39289-0631
WATER WELL DRILLERS LOG

COUNTY WELL LOCATED
Jackson

WELL NUMBER G 2131 CODED

DATE WELL COMPLETED
4-17-95

PERMIT NUMBER

NAME OF DRILLING FIRM
Coast Water Well Service

NAME & MAILING ADDRESS OF LANDOWNER
Edward Reeves

Red Top Lane

Pascagoula Ms

WELL LOCATION: SEC 23 TOWNSHIP 5 RANGE 6

DISTANCE 3 1/2 MILES DIRECTION South of NEAREST TOWN Wilde

OTHER LANDMARK

WELL PURPOSE Home Irrigation, Municipal, Industrial, Fish Pond, etc.

PUMP DATA

PUMP TYPE (Circle One):
Submersible, Turbine, Jet, Flowing Well, Other (Describe) _____

POWER TYPE (Circle One):
 Electric, Tractor, Diesel, Gasoline, Butane, Other (Describe) _____ H/P 1

Pump Capacity (GPM) 12 No. of Stages 2 Setting Depth _____ FT.

PUMP TEST

Well yielded _____ GPM with a drawdown of _____ ft. after _____ hours of pumping

WELL DATA

Well Depth <u>75'</u>	Casing Diameter (In.) <u>2"</u>	Casing Length (Ft.) <u>65'</u>
Type of Casing <u>PVC</u>	Hole Depth <u>75'</u>	Depth to Static Water Level <u>20'</u>

TYPE OF COMPLETION: (Circle One or More):
 Gravel Packed, Underreamed, Telescoped, Natural Development, Open Hole, Other (Describe) _____

WELL GROUTED TO A DEPTH OF 20 FEET
Type Grout (circle one): Cement, Bentonite, or Mix

LOG DATA

TYPE OF LOG RUN (Circle One):
Electric, Gamma Ray, Density, Sonic, Neutron, Other (Describe) _____ No Log Run

Name of Organization Running Log _____

SCREEN DATA

Diameter - Inches <u>2"</u>	Length - Feet <u>10'</u>	Slot Size - Inches <u>.008</u>
Screen Type <u>PVC</u>	Depth to Bottom - Feet <u>75'</u>	

GEOLOGIC DATA (Office Use Only)

Surface Elev.	Geologic Unit	Unit Thickness	Depth to Top
Subs. SWL	Date	Analysis	Aquifer Test


Driller's Remarks

DESCRIPTION OF FORMATIONS ENCOUNTERED	FROM	TO	FORMATIONS (Continued)	FROM	TO
<u>Top Soil</u>	<u>0</u>	<u>2</u>	RECEIVED MAY 15 1995 Dept. of Environmental Quality Office of Land & Water Resources		
<u>Fine sand</u>	<u>2</u>	<u>8</u>			
<u>Grey & Red clay</u>	<u>8</u>	<u>25</u>			
<u>M. sd. Coarse sand</u>	<u>25</u>	<u>75</u>			

IF MORE SPACE IS NEEDED, USE BACK

If well telescopes please sketch and show depths.

GROUND LEVEL

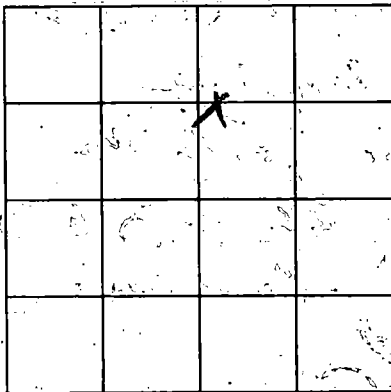

SECTION 23

Please indicate well location X.

ADDITIONAL INFORMATION

If more than one screen,
show location of each on sketch.