

MISSISSIPPI DEPARTMENT OF ENVIRONMENTAL QUALITY
Office of Land and Water Resources

P. O. Box 10631
 Jackson, MS 39289-0631
WATER WELL DRILLERS LOG

COUNTY WELL LOCATED JACKSON	
WELL NUMBER G-2166	CODED
DATE WELL COMPLETED 11-3-00	

PERMIT NUMBER
NAME OF DRILLING FIRM Const Water Well Service

NAME & MAILING ADDRESS OF LANDOWNER Jed Lavergne			
Poseygonula River Rd.			
Poseygonula, Ms			
WELL LOCATION	SEC	TOWNSHIP	RANGE
	27	5	6
DISTANCE	DIRECTION	NEAREST TOWN	
4 Miles	SOUTH of	WADE	
OTHER LANDMARK			
WELL PURPOSE: <input checked="" type="checkbox"/> Home, <input type="checkbox"/> Irrigation, <input type="checkbox"/> Municipal, <input type="checkbox"/> Industrial, <input type="checkbox"/> Fish Pond, etc.			

PUMP DATA		
PUMP TYPE (Circle One): Submersible, Turbine, <input checked="" type="radio"/> Other (Describe) Flowing Well		
POWER TYPE (Circle One): <input checked="" type="radio"/> Electric, <input type="radio"/> Tractor, <input type="radio"/> Diesel, <input type="radio"/> Gasoline, <input type="radio"/> Butane. Other (Describe) H/P 1/2		
Pump Capacity (GPM) 7	No. of Stages 1	Setting Depth FT.
PUMP TEST		
Well yielded _____ GPM with a drawdown of _____ ft. after _____ hours of pumping		

WELL DATA		
Well Depth 172'	Casing Diameter (In.) 2"	Casing Length (Ft.) 10'
Type of Casing PVC	Hole Depth 172'	Depth to Static Water Level 10'
TYPE OF COMPLETION: (Circle One or More): <input checked="" type="checkbox"/> Gravel Packed, <input type="checkbox"/> Underreamed, <input type="checkbox"/> Telescoped, <input checked="" type="checkbox"/> Natural Development, <input type="checkbox"/> Open Hole, <input type="checkbox"/> Other (Describe)		

LOG DATA	
TYPE OF LOG RUN (Circle One): Electric, Gamma Ray, Density, Sonic, Neutron, Other (Describe) No Log Run	
Name of Organization Running Log	

WELL GROUTED TO A DEPTH OF 20 FEET Type Grout (circle one): Cement, <input checked="" type="radio"/> Bentonite, or Mix
--

GEOLOGIC DATA (Office Use Only)			
Surface Elev.	Geologic Unit	Unit Thickness	Depth to Top
Subs. SWL	Date	Analysis	Aquifer Test
Driller's Remarks			

SCREEN DATA			
Diameter - inches 2"	Length - Feet 10'	Slot Size - Inches .008	
Screen Type PVC	Depth to Bottom - Feet 172'		

Top of Log Pipe or Reduction in Casing FEET	IF TELESCOPED OR MORE THAN ONE SCREEN, USE BACK PAGE
JAN 17 2001	


DESCRIPTION OF FORMATIONS ENCOUNTERED	FROM	TO
Top Soil	0	2
Brown Clay	2	10
White coarse Sand	10	65
Brown Clay	65	80
White coarse Sand	80	108
Brown Clay	108	110
Gray coarse Sand	110	155
Blue Clay	155	172

FORMATIONS (Continued)	FROM	TO
Dept. of Environmental Quality Office of Land & Water Resource		

IF MORE SPACE IS NEEDED, USE BACK

If well telescopes please
sketch and show depths.

GROUND LEVEL

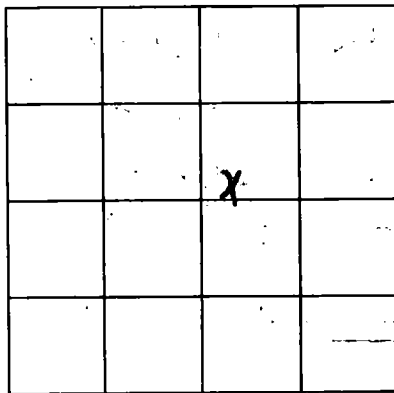

SECTION 27

Please indicate well location X.

ADDITIONAL INFORMATION

RECEIVED
WATER RESOURCES
DIVISION
DEPT. OF WATER RESOURCES
WASHINGTON, D.C. 20006

If more than one screen,
show location of each on sketch.