

Jackson
H
10-63

MISSISSIPPI BOARD OF WATER COMMISSIONERS

can't locate

WATER WELL DRILLERS LOG

Date: OCT 1, 1963, Driller: George Colville County: Jackson

(Name)


Cleveland
(1) Owner of Land: DeMORRIS CUMBER
(Name)
Wade, Miss
(Address)
(2) Location: NW 1/4, SW 1/4, Sec. 14 T33R5W
18 miles N, of Mass Point
(distance) (direction) (Nearest Town)
(3) Topography: FLAT
(Hilly) (Flat) (Level)
(4) Purpose of Well: Dom
(Domestic Irrigation
Municipal, Industrial, Other)

Description & Color of Materials Sand, Clay, Red Clay, Shell, etc.	Thick- ness Feet	Depth Feet
Red Clay	16	16
SAND	2	18
CLAY	4	22
SAND	22	44
GRAVEL	55	99
Blue Clay	295	396
FINE SAND	22	418
CLAY	22	440
FINE SAND	22	462
FINE SAND	22	484
CLAY	78	562
FINE SAND	10	572
CLAY	199	771
SANDY CLAY	5	776
FINE SAND	12	788
SAND	38	820

Information upon completion of well:

(1) Diameter: 2 inches.
(2) Total Depth: 820 feet.
(3) Water Level: +19'-8" Above ground.
(4) Cased to: 810, Size 2 in.
(5) Screen: Size .008, Length 10'
(6) Were any formations sealed against pollution?
yes, no.

If YES depth of formation _____
Why _____
Drillers Remarks: _____

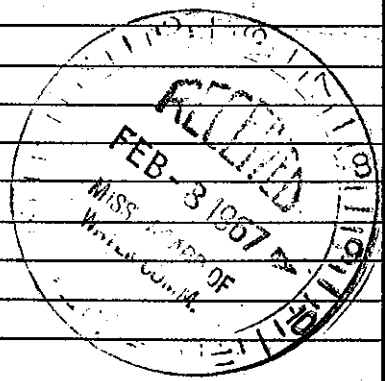

Well No.
266

(Use Back Side)

Mail this copy to Board of Water Commissioners 429 Miss. St. Jackson, Miss.