

# JACKSON MISSISSIPPI BOARD OF WATER COMMISSIONERS

H 13

## WATER WELL DRILLERS LOG

H 300

12-1-60

Date: 12/1, 1960, Driller: Colville Water Supply Co County Jackson

4 @

(1) Owner of Land: TM Horton  
(Name)

Hurley Miss  
(Address)

(2) Location: SE 1/4 SW 1/4, Sec. 4 T8S R5W

2 miles South of Hurley  
(distance) (direction) (Nearest Town)

(3) Topography: \_\_\_\_\_  
(Hilly) (Flat) (Level)

(4) Purpose of Well: \_\_\_\_\_  
(Domestic ) (Irrigation) (Municipal) (Industrial) (Other)

Information upon completion of well:

(1) Diameter: 2 inches.

(2) Total Depth: 372 feet.

(3) Water Level: 23' 6" feet below top of ground.

(4) Cased to \_\_\_\_\_, Size \_\_\_\_\_

(5) Screen: Size 2, Length 10'


(6) Were any formations sealed against pollution?  
\_\_\_\_\_ yes, \_\_\_\_\_ no.

If YES depth of formation \_\_\_\_\_

Why \_\_\_\_\_

Drillers Remarks: \_\_\_\_\_

Description & Color of Materials Sand, Clay, Red Clay, Shell, etc.		Thick- ness Feet	Depth Feet
0	CLAY	10	CLAY
15	white sand	21	Gravel
42	Soft white clay	63	SW clay
84	sandy clay	90	yellow clay
105	yellow clay	126	y clay
147	y clay	168	y clay
189	y clay	210	Blue clay
231	B clay	252	B clay
273	B clay	284	B clay
294	Britty clay	310	B clay
315	B clay	320	Rock
322	Fine sand	336	SAND
372	TD		

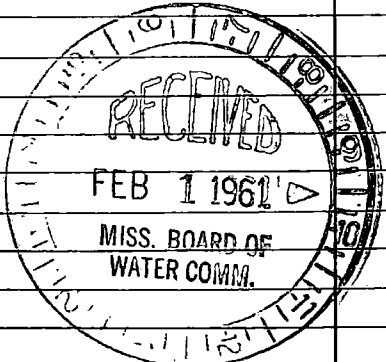

Well No. 54

(Use Back Side)

