

JACKSON MISSISSIPPI BOARD OF WATER COMMISSIONERS

H 15

2-4-63

WATER WELL DRILLERS LOG

Date: Feb 4, 1963, Driller: George Colville County Jackson

5 R

(Name)

(1) Owner of Land: PINK
(Name)

Blades

(Address)

(2) Location: NE 1/4, SE 1/4, Sec. 14 T.5 R.5,

18 miles North of Miss Point
(distance) (direction) (Nearest Town)

(3) Topography: Flat
(Hilly) (Flat) (Level)

(4) Purpose of Well: Dom.
(Domestic Irrigation
Municipal, Industrial, Other)

Information upon completion of well:

(1) Diameter 1 1/4 inches.

(2) Total Depth 455 feet.

(3) Water Level +5' feet below top of ground.

(4) Cased to _____, Size 80 ga

(5) Screen: Size 1 1/4, Length 10

(6) Were any formations sealed against pollution?

_____ yes, no.

If YES depth of formation _____

Why _____

Drillers Remarks: _____

Description & Color of Materials
Sand, Clay, Red Clay, Shell, etc.

Thick-
ness
Feet


Depth
Feet

Clay 0 48

Sand & Gravel 72 120

Clay & Gritty Clay 114 434

Sand 21 455

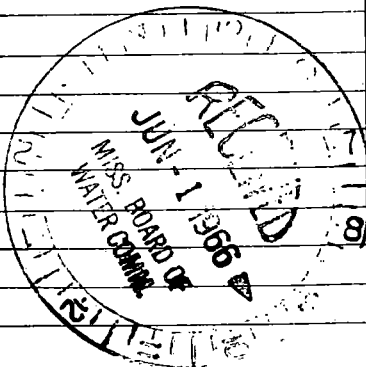

Well No. 201

(Use Back Side).

