

49

MISSISSIPPI
 BOARD OF WATER COMMISSIONERS
 416 North State Street
 Jackson, Mississippi. 39201

WATER WELL DRILLERS LOG

4-17 1967 Coast Water Well Co Jackson
 date well completed firm name county well located

LANDOWNER: Temple Baptist Church
Big Point
 (mailing address)

description of formations encountered	from	to
<u>Red Clay</u>	<u>0</u>	<u>22</u>
<u>hard mudstone</u>	<u>22</u>	<u>43</u>
<u>Blue Clay</u>	<u>43</u>	<u>220</u>
<u>hard mudstone</u>	<u>220</u>	<u>262</u>

WELL LOCATION:
 sec. 33 T 5 N R 5 E
5 miles South of Big Point
 (distance) (direction) (nearest town)


WELL PURPOSE: Church
 (home, irrigation, municipal, industrial)

WELL COMPLETION DATA:

- (1) diameter (inches) 2
- (2) total depth (feet) 262
- (3) static water level (feet) 6 below above top of ground.
- (4) casing Gal 252
 (material) (depth)
2" if telescope see back.
 (size)
- (5) screen 10' 252
 (length) (depth to top)
2' Stainless Steel
 (size) (material)
- (6) pump 1/2 700
 (HP) (yield gpm)
Elect
 (type power)
- (7) electric log NO
 (yes or no)
 (organization running log)

(8) how well bottom plugged
Back Wash Valve


DRILLERS REMARKS:

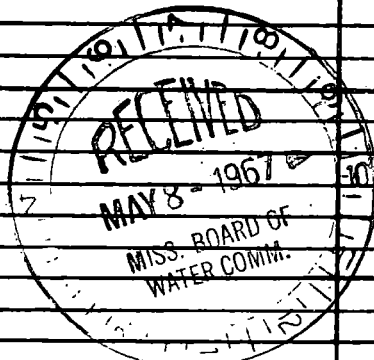

If well telescopes please sketch and show depths.

GROUND LEVEL

NW SE

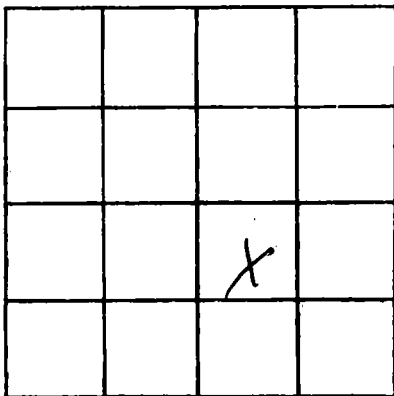

SECTION 33

Please indicate well location X.

ADDITIONAL INFORMATION

If more than one screen, show locations of each on sketch.