

JACKSON
H 17
9-64

MISSISSIPPI
BOARD OF WATER COMMISSIONERS
416 North State Street
Jackson, Mississippi 39201

WATER WELL DRILLERS LOG

Sept 7 1964 Central Water Supply Jackson
date well completed firm name county well located

LANDOWNER: R. B. Suter
Quitman
Big Forest Miss
(mailing address)

description of formations encountered	from	to
flush	0	15
sand and gravel	15	132
clay	132	254
sand	254	264
clay	264	440
sand	440	465

WELL LOCATION:
sec. 21 T. 5 N. R. 5 E.
1/2 miles North of Big Forest
(distance) (direction) (nearest town)

WELL PURPOSE: Home
(home, irrigation, municipal, industrial)


- WELL COMPLETION DATA:
- (1) diameter (inches) 2
 - (2) total depth (feet) 465
 - (3) static water level (feet) 18 below above top of ground.
 - (4) casing galv 465
(material) (depth)
 - _____ if telescope see back.
(size)
 - (5) screen 10 455
(length) (depth to top)
 - 2" Standard
(size) (material)
 - (6) pump _____
(HP) (yield gpm)
 - _____ (type power)
 - (7) electric log no
(yes or no)
 - _____ (organization running log)
 - (8) how well bottom plugged BP

DRILLERS REMARKS: Bound
installed by owner

MAY 27 1968
MISS. BOARD OF
WATER

If well telescopes please sketch and show depths.

GROUND LEVEL

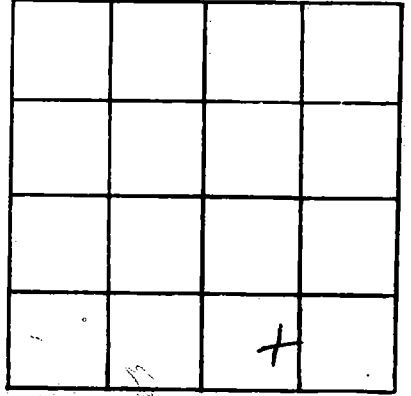

SECTION _____

Please indicate well location X.

ADDITIONAL INFORMATION

If more than one screen, show locations of each on sketch.