

Jackson
H 18
5-13-65

MISSISSIPPI
BOARD OF WATER COMMISSIONERS
416 North State Street
Jackson, Mississippi 39201

INDEXED

WATER WELL DRILLERS LOG

May 13 1965 Cabille Water Supply Jackson
date well completed firm name county well located

LANDOWNER: Levon Jones
Big Point Miss
(mailing address)


description of formations encountered	from	to
Clay	17	22
sand	22	98
Clay	98	235
sand	235	265

WELL LOCATION:
sec. 33 T 5 N R 5 E
(distance) miles of (direction) of (nearest town)

WELL PURPOSE: Home
(home, irrigation, municipal, industrial)


- WELL COMPLETION DATA:
- (1) diameter (inches) 2"
 - (2) total depth (feet) 270
 - (3) static water level (feet) 10 ^{below} _{above} top of ground.
 - (4) casing 2 1/2" (material), (depth),
If telescope see back. (size)
 - (5) screen 5' (length), 265' (depth to top)
2" (size), stainless (material)
 - (6) pump (HP) (yield gpm)
(type power)
 - (7) electric log no (yes or no)
(organization running log)
 - (8) how well bottom plugged BPL

DRILLERS REMARKS: Pump installed by owner

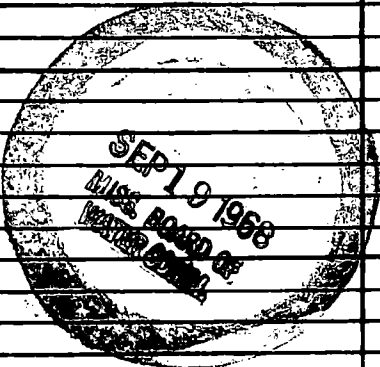

If well telescopes please sketch and show depths.

GROUND LEVEL

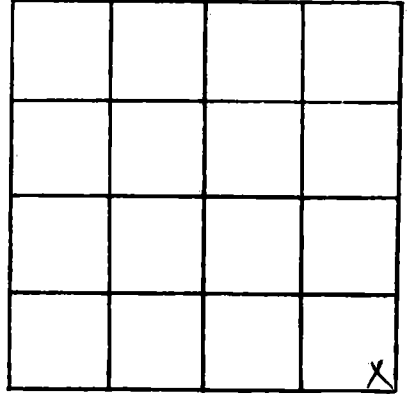

SECTION 33

Please indicate well location X.

ADDITIONAL INFORMATION

If more than one screen, show locations of each on sketch.