

Jackson.
H 19
11-65

MISSISSIPPI
BOARD OF WATER COMMISSIONERS
416 North State Street
Jackson, Mississippi 39201

CODED

WATER WELL DRILLERS LOG

Apr 17 1965 date well completed
Cobville Water Supply firm name
Jackson county well located

LANDOWNER: J. C. Farr
Big Point
(mailing address)

description of formations encountered	from	to
Clay	0	10
Sand	10	60
Clay	60	64
sand	64	69

WELL LOCATION:
sec. 28 T 5 N R 5 E
5 miles (distance) S of Hurdon (nearest town)

WELL PURPOSE: home
(home, irrigation, municipal, industrial)

WELL COMPLETION DATA:

(1) diameter (inches) 1 1/4

(2) total depth (feet) 69

(3) static water level (feet) 10 (below top of ground)

(4) casing Galv. material (depth) _____
(size) If telescope see back.

(5) screen 5' length, 64' depth to top
1 1/4" Copper Gauge material

(6) pump _____ (HP) _____ (yield gpm)
(type power)

(7) electric log no (yes or no)
(organization running log)

(8) how well bottom plugged B.P. Galv.

CODED


DRILLERS REMARKS: Pump installed by owner

MAR 10 1969

MISS. BD. OF WATER COMMISSIONERS

If well telescopes please sketch and show depths.

GROUND LEVEL

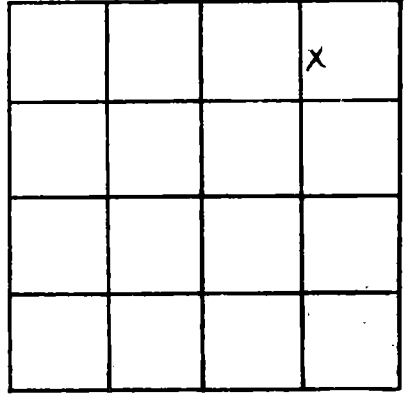

SECTION 28

Please indicate well location X.

ADDITIONAL INFORMATION

If more than one screen, show locations of each on sketch.