

JACKSON  
H 20  
5-17-67

MISSISSIPPI  
BOARD OF WATER COMMISSIONERS  
416 North State Street  
Jackson, Mississippi 39201

WATER WELL DRILLERS LOG

May 17 1967 Robbie Water Drugg Jackson  
well completed firm name county well located


| LANDOWNER: <u>Dernon Pierce</u>   | description of formations encountered | from                  | to                     |
|---|---------------------------------------|-----------------------|------------------------|
| <u>Wade Miss</u><br>(mailing address)   | <u>clay</u><br><u>sand</u>            | <u>0</u><br><u>49</u> | <u>14</u><br><u>51</u> |
| WELL LOCATION:<br><u>2</u> miles <u>S</u> of <u>Wade</u><br>(distance) (direction) (nearest town)   |                                       |                       |                        |
| WELL PURPOSE: <u>home</u><br>(home, irrigation, municipal, industrial)  |                                       |                       |                        |
| WELL COMPLETION DATA:<br>(1) diameter (inches) <u>2</u><br>(2) total depth (feet) <u>51</u><br>(3) static water level (feet) _____ below above top of ground.<br>(4) casing <u>galv</u> (material) _____ (depth) _____ (size) If telescope see back.<br>(5) screen <u>5</u> (length) <u>46</u> (depth to top) <u>2</u> (size) <u>plastic</u> (material)<br>(6) pump _____ (HP) _____ (yield gpm) _____ (type power)<br>(7) electric log <u>no</u> (yes or no) _____ (organization running log)<br>(8) how well bottom plugged <u>BP valve</u> |                                       |                       |                        |
| DRILLERS REMARKS:   |                                       |                       |                        |

APR 21 1969

MISS. BD. OF  
WATER COMM.

If well telescopes please sketch and show depths.

GROUND LEVEL

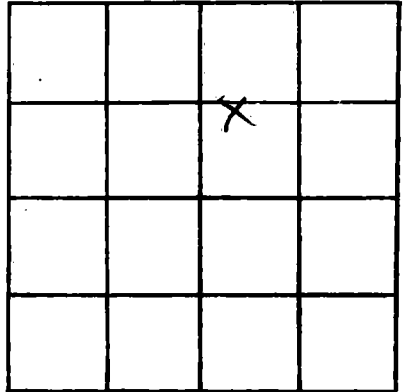

SECTION ~~22~~ 22

Please indicate well location X.

ADDITIONAL INFORMATION

If more than one screen, show locations of each on sketch.