

Jackson  
H23  
8-4-67

MISSISSIPPI  
BOARD OF WATER COMMISSIONERS  
416 North State Street  
Jackson, Mississippi 39201

CODED

WATER WELL DRILLERS LOG

8-4 1967 Coburn Water Svc Jackson  
date well completed firm name county well located

LANDOWNER: <u>Mack</u>	description of formations encountered	from	to
<u>Mason #2</u>			
<u>Big Point Miss</u> (mailing address)	<u>Shud</u>	<u>0</u>	<u>15</u>
	<u>clay</u>	<u>15</u>	<u>22</u>
	<u>sand</u>	<u>22</u>	<u>44</u>
WELL LOCATION:			
sec. <u>11</u> T. <u>5</u> N. R. <u>5</u> E.			
<u>4</u> miles <u>SE</u> of <u>Husley</u>			
(distance) (direction) (nearest town)			
WELL PURPOSE: <u>home</u> (home, irrigation, municipal, industrial)			
WELL COMPLETION DATA:			
(1) diameter (inches) <u>2</u>			
(2) total depth (feet) <u>44</u>			
(3) static water level (feet) <u>22</u> <u>below</u> above top of ground.			
(4) casing <u>Plastic</u> (material) (depth)			
(size) If telescope see back.			
(5) screen <u>5</u> <u>39</u> (length) (depth to top)			
<u>2</u> <u>plastic</u> (size) (material)			
(6) pump <u>1/2</u> <u>5</u> (HP) (yield gpm)			
<u>elec</u> (type power)			
(7) electric log <u>no</u> (yes or no)			
(organization running log)			
(8) how well bottom plugged <u>BPVally</u>			
DRILLERS REMARKS:			


CODED

APR 21 1969

MISS. BD. OF  
WATER COMM.

If well telescopes please  
sketch and show depths.

GROUND LEVEL

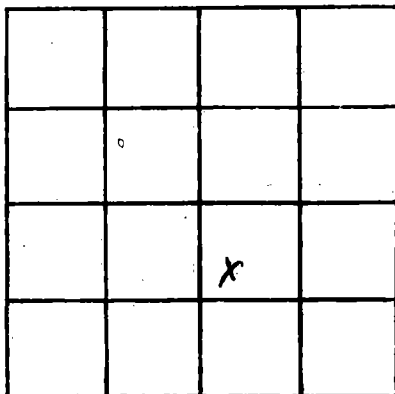

SECTION 4

Please indicate well location X.

ADDITIONAL INFORMATION

If more than one screen,  
show locations of each on sketch.