

CODED

MISSISSIPPI  
BOARD OF WATER COMMISSIONERS  
416 North State Street  
Jackson, Mississippi 39201

WATER WELL DRILLERS LOG

Jackson  
H27.  
10-9-68

Oct 9 1968 Colville Water Supply Jackson  
date well completed firm name county well located


LANDOWNER: Robert Long Big Point (mailing address)	description of formations encountered	from	to
	sand	16	66
	clay	66	158
	sand	158	169
WELL LOCATION: sec. 21 T. 5 N. R. 5 E. 10 miles NE of Boakump (distance) (direction) (nearest town)			
WELL PURPOSE: Home (home, irrigation, municipal, industrial)			
WELL COMPLETION DATA: (1) diameter (inches) 2 (2) total depth (feet) 169 (3) static water level (feet) 27 below above top of ground. (4) casing galv, 165, (material) (depth) 2 (size) if telescope see back. (5) screen 4' (length) (depth to top) 2" plastic (size) (material) (6) pump (HP) (yield gpm) (type power) (7) electric log no (yes or no) (organization running log) (8) how well bottom plugged BP Valve			
DRILLERS REMARKS: pump installed, city owner			

JAN 8 1970

MISS. DD. 66  
WATER COMM.

If well telescopes please sketch and show depths.

GROUND LEVEL

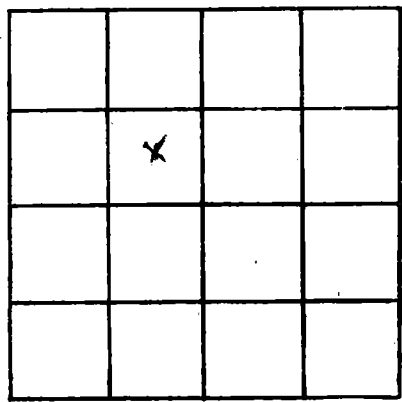

SECTION 21

Please indicate well location X.

ADDITIONAL INFORMATION

If more than one screen, show locations of each on sketch.