

CODED

MISSISSIPPI
 BOARD OF WATER COMMISSIONERS
 416 North State Street
 Jackson, Mississippi 39201

WAR 22 1972

WATER WELL DRILLERS LOG

JACKSON
H31
3-10-72

3-10 1972 Coast Water Well Serv Jackson
 date well completed firm name county well located

LANDOWNER:	description of formations encountered	from	to
<u>Jimmy Dickerson</u> <u>Pt - 3 Box 46</u>	<u>top soil</u>	<u>0</u>	<u>21</u>
<u>Joscoyola, Miss.</u> (mailing address)	<u>coarse sand + gravel</u>	<u>21</u>	<u>84</u>
WELL LOCATION: sec. <u>21</u> T. <u>5</u> N. R. <u>5</u> W. <u>1/2</u> miles <u>north</u> of <u>Big Point</u> (distance) (direction) (nearest town)	<u>blue clay</u>	<u>84</u>	<u>241</u>
WELL PURPOSE: <u>home</u> (home, irrigation, municipal, industrial)	<u>sand - fine to med.</u>	<u>241</u>	<u>283</u>
WELL COMPLETION DATA: (1) diameter (inches) <u>2"</u> (2) total depth (feet) <u>283</u> (3) static water level (feet) <u>50</u> below above top of ground. (4) casing <u>galv.</u> , <u>273'</u> (material) (depth) <u>2"</u> if telescope see back. (size) (5) screen <u>10'</u> , <u>273'</u> (length) (depth to top) <u>2"</u> , <u>stainless basket</u> (size) (material) (6) pump <u>1</u> , <u>8</u> (HP) (yield gpm) <u>elec</u> (type power) (7) electric log <u>NO</u> (yes or no) (organization running log) (8) how well bottom plugged <u>back-</u> <u>wash valve</u>			


CODED

DRILLERS REMARKS:

07060

If well telescopes please sketch and show depths.

GROUND LEVEL

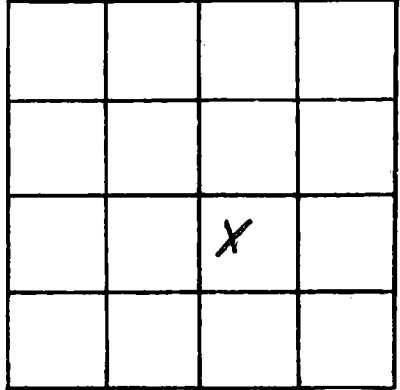

SECTION 21

Please indicate well location X.

ADDITIONAL INFORMATION

Lined area for additional information.

07060

If more than one screen, show locations of each on sketch.