

JACKSON
H32
5-3-72

MISSISSIPPI
BOARD OF WATER COMMISSIONERS
416 North State Street
Jackson, Mississippi 39201

CODED

WATER WELL DRILLERS LOG

Mar. 3, 1972 date well completed
C. Colwell, Inc. firm name
Jackson county well located


LANDOWNER: <u>Morris</u>	description of formations encountered	from	to
<u>Carley</u>			
<u>Helena, Miss.</u> (mailing address)	<u>Sand</u> <u>Clay</u> <u>SAND</u>	<u>0</u> <u>205</u> <u>296</u>	<u>205</u> <u>296</u> <u>306</u>
WELL LOCATION:			
sec. <u>2</u> T. <u>5</u> N. R. <u>5</u> E. <u>10</u> miles <u>NE</u> of <u>Mass Point</u> (distance) (direction) (nearest town)			
WELL PURPOSE: <u>Home</u> (home, irrigation, municipal, industrial)			
WELL COMPLETION DATA:			
(1) diameter (inches) <u>2 1/4</u>			
(2) total depth (feet) <u>306</u>			
(3) static water level (feet) <u>+30</u> <u>below</u> <u>above</u> top of ground.			
(4) casing <u>galv.</u> <u>301</u> (material) (depth)			
(size) If telescope see back.			
(5) screen <u>5'</u> <u>301</u> (length) (depth to top)			
<u>2</u> <u>stain.</u> (size) (material)			
(6) pump <u>1/8</u> <u>6</u> (HP) (yield gpm)			
<u>E. bar</u> (type power)			
(7) electric log <u>No</u> (yes or no)			
(organization running log)			
(8) how well bottom plugged <u>D.P. valve</u>			
DRILLERS REMARKS:			

CODED


SEP 28 1972

MISS. BD. OF
WATER COMM.

If well telescopes please sketch and show depths.

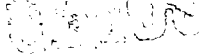

GROUND LEVEL

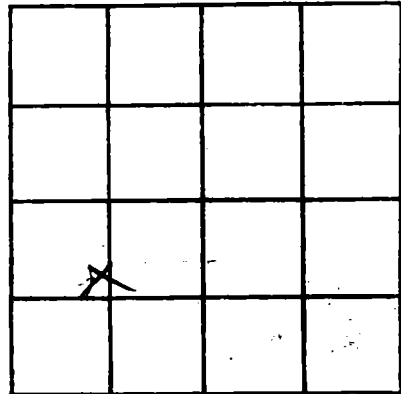

SECTION 2

Please indicate well location X.

ADDITIONAL INFORMATION

Lined area for providing additional information, consisting of 20 horizontal lines.

If more than one screen, show locations of each on sketch.