

JACKSON
H 34
12-12-72

MISSISSIPPI
BOARD OF WATER COMMISSIONERS
416 North State Street
Jackson, Mississippi 39201

CODED

WATER WELL DRILLERS LOG

Dec 12 1972 Colville Water Supply Jackson
date well completed firm name county well located


LANDOWNER: <u>Bryan</u>	description of formations encountered	from	to
<u>Burkett</u>			
<u>Hurley Ms</u> (mailing address)	<u>Sand</u>	<u>0</u>	<u>131</u>
	<u>clay</u>	<u>131</u>	<u>215</u>
	<u>sand</u>	<u>215</u>	<u>236</u>
WELL LOCATION:			
sec. <u>10</u> T. <u>5</u> N R. <u>5</u> E <u>3</u> miles <u>SE</u> of <u>Hurley</u> (distance) (direction) (nearest town)			
WELL PURPOSE: <u>home</u> (home, irrigation, municipal, industrial)			
WELL COMPLETION DATA:			
(1) diameter (inches) <u>2</u>			
(2) total depth (feet) <u>236</u>			
(3) static water level (feet) <u>20</u> <u>below</u> top of ground			
(4) casing <u>galv</u> <u>231</u> (material) (depth)			
(size) If telescope see back.			
(5) screen <u>5</u> <u>231</u> (length) (depth to top)			
<u>2"</u> <u>Stain</u> (size) (material)			
(6) pump <u>1/2</u> <u>10</u> (HP) (yield gpm)			
<u>elec</u> (type power)			
(7) electric log <u>no</u> (yes or no)			
(organization running log)			
(8) how well bottom plugged <u>B.P. Valve</u>			
DRILLERS REMARKS:			

CODED

APP 4 1972

If well telescopes please sketch and show depths.

GROUND LEVEL

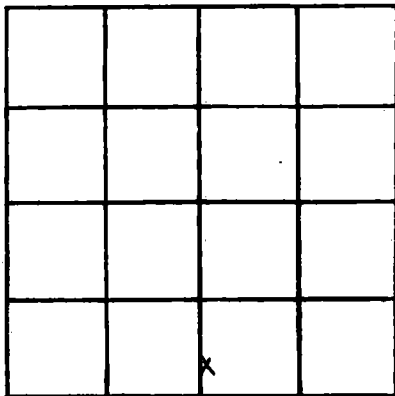

SECTION 10

Please indicate well location X.

ADDITIONAL INFORMATION

If more than one screen, show locations of each on sketch.