

JACKSON
H35
9-9-72

MISSISSIPPI
BOARD OF WATER COMMISSIONERS
416 North State Street
Jackson, Mississippi 39201

CODED

WATER WELL DRILLERS LOG

Sept 9 1972 Colville Water Supply JACKSON
date well completed firm name county well located


LANDOWNER: <u>Bobby Vice</u>	description of formations encountered	from	to
<u>Hurley MS</u> (mailing address)	<u>Sand</u> <u>Clay</u> <u>Sand</u>	<u>0</u> <u>.132</u> <u>397</u>	<u>132</u> <u>347</u> <u>364</u>
<p>WELL LOCATION: sec <u>10</u> T. <u>5</u> N R. <u>5</u> E <u>2 1/2</u> miles <u>North</u> of <u>Big Point</u> (distance) (direction) (nearest town)</p>			
<p>WELL PURPOSE: <u>home</u> (home, irrigation, municipal, industrial)</p>			
<p>WELL COMPLETION DATA:</p> <p>(1) diameter (inches) <u>2</u></p> <p>(2) total depth (feet) <u>364</u></p> <p>(3) static water level (feet) <u>21</u> <u>below</u> <u>above</u> top of ground.</p> <p>(4) casing <u>Galv</u>, <u>359</u> (material) (depth)</p> <p>(size) if telescope see back.</p> <p>(5) screen <u>5'</u>, <u>359</u> (length) (depth to top)</p> <p><u>2</u>, <u>Stainless</u> (size) (material)</p> <p>(6) pump <u>1/2</u>, <u>8</u> (HP) (yield gpm)</p> <p><u>elec</u> (type power)</p> <p>(7) electric log <u>no</u> (yes or no)</p> <p>(organization running log)</p> <p>(8) how well bottom plugged <u>BP Valve</u></p>			
<p>DRILLERS REMARKS:</p>			

CODED

If well telescopes please sketch and show depths.

GROUND LEVEL

U

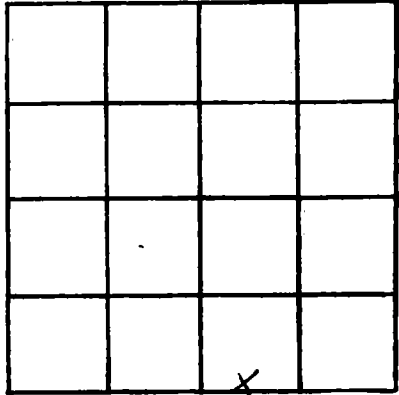

SECTION 10

Please indicate well location X.

ADDITIONAL INFORMATION

If more than one screen, show locations of each on sketch.