

JACKSON
 H 36
 4-10-73

MISSISSIPPI
 BOARD OF WATER COMMISSIONERS
 416 North State Street
 Jackson, Mississippi 39201

WATER WELL DRILLERS LOG

CODED

April 10 1973 *Diffin Well Co* *Jackson*
 date well completed firm name county well located

LANDOWNER:
John Hammonds R13
Pascagoula Miss
 (mailing address)

description of formations encountered	from	to
<i>red silty clay</i>	<i>0</i>	<i>1'</i>
<i>yellow clay</i>	<i>1'</i>	<i>15'</i>
<i>fine white sand</i>	<i>15'</i>	<i>36'</i>
<i>yellow & white clay</i>	<i>35'</i>	<i>41'</i>
<i>med to coarse white sand</i>	<i>41'</i>	<i>58'</i>

WELL LOCATION:
 sec 33 T 5 N R 5 E
 (distance) miles 7 South of HOOVER
 (direction) (nearest town)

WELL PURPOSE:
 (home, irrigation, municipal, industrial)

WELL COMPLETION DATA:
 (1) diameter (inches) 3"
 (2) total depth (feet) 58'
 (3) static water level (feet) 7 below above top of ground.
 (4) casing PVC 53'
 (material) (depth)
 (size) If telescope see back.
 (5) screen 5' 53'
 (length) (depth to top)
2" PVC
 (size) (material)
 (6) pump 1/3 APPX 13
 (HP) (yield gpm)
ELE
 (type power)
 (7) electric log NO
 (yes or no)
 (organization running log)

CODED


(8) how well bottom plugged
Back with valve

7/19/73

DRILLERS REMARKS:

If well telescopes please sketch and show depths.

GROUND LEVEL

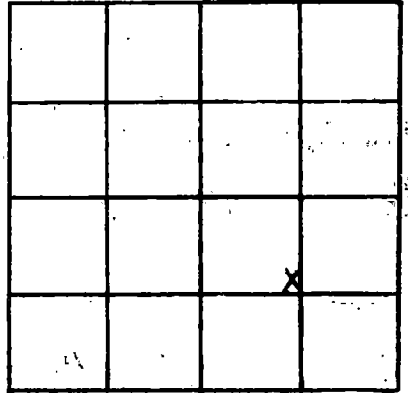

SECTION 33

Please indicate well location X.

ADDITIONAL INFORMATION

If more than one screen,
show locations of each on sketch.