

H 37
 JACKSON
 7-11-73

MISSISSIPPI
 BOARD OF WATER COMMISSIONERS
 416 North State Street
 Jackson, Mississippi 39201

CODED

WATER WELL DRILLERS LOG

7-11-1923 date well completed
 23 Griffin Wells firm name
 Jackson county well located

LANDOWNER: Pine Grove
 Church of God
 Passapatanz Miss
 (mailing address)

WELL LOCATION:
 sec. 6 T. 5 N. R. 4 E
 4 miles east of Husley
 (distance) (direction) (nearest town)

WELL PURPOSE: Home
 (home, irrigation, municipal, industrial)

- WELL COMPLETION DATA:
- (1) diameter (inches) 2"
 - (2) total depth (feet) 50
 - (3) static water level (feet) 31' below top of ground.
 - (4) casing PVC 45' (material) (depth)
 - (5) screen 5' 45' (length) (depth to top)
 2" PVC (size) (material)
 - (6) pump 1 12 (HP) (yield gpm)
 ele. (type power)
 - (7) electric log no (yes or no)
 - (8) how well bottom plugged
 Bar Wash


description of formations encountered	from	to
red clay	0	6'
red to white clay	6'	15'
red sand		
white sand fine	12'	20'
yellow + white clay streaks	30'	38'
med to finely coarse white sand	28'	30'

DRILLERS REMARKS:

AUG 16 1973

If well telescopes please sketch and show depths.

GROUND LEVEL

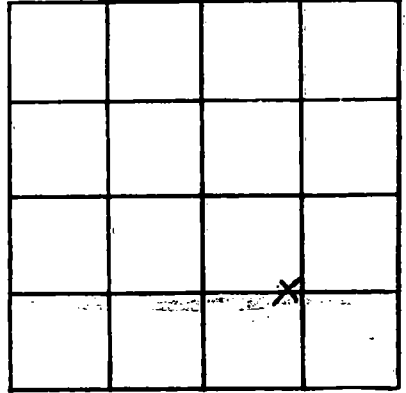

SECTION 6

Please indicate well location X.

ADDITIONAL INFORMATION

If more than one screen, show locations of each on sketch.