

H38  
JACKSON  
10-12-73

MISSISSIPPI  
BOARD OF WATER COMMISSIONERS  
416 North State Street  
Jackson, Mississippi 39201

CODED

WATER WELL DRILLERS LOG

Oct 12 1973 date well completed  
Riffin Wells Co firm name  
Jackson county well located

LANDOWNER:  
David S. Kays  
Rt. 1 Passapatan, Miss.  
(mailing address)

| description of formations encountered | from | to  |
|---------------------------------------|------|-----|
| red clay                              | 0'   | 8'  |
| white to yellow clay streaks          | 8'   | 20' |
| white sand & clay streaks             | 20'  | 35' |
| coarse white sand                     | 35'  | 55' |

WELL LOCATION:  
sec. 6 T 5 N R 4 E S W  
4 miles east of Houliday  
(distance) (direction) (nearest town)

WELL PURPOSE: Home  
(home, irrigation, municipal, industrial)

- WELL COMPLETION DATA:
- (1) diameter (inches) 2
  - (2) total depth (feet) 52
  - (3) static water level (feet) 32' below top of ground.
  - (4) casing PVC 45' (material) (depth)  
2" (size) If telescope see back.
  - (5) screen 5' 45' (length) (depth to top)  
2" (size) PVC (material)
  - (6) pump 1 (HP) 12 (yield gpm)  
ele (type power)
  - (7) electric log no (yes or no)
- (organization running log)
- (8) how well bottom plugged B.W.V.


NOV 13 1973

MISS. BD OF WATER

DRILLERS REMARKS:

If well telescopes please sketch and show depths.

GROUND LEVEL

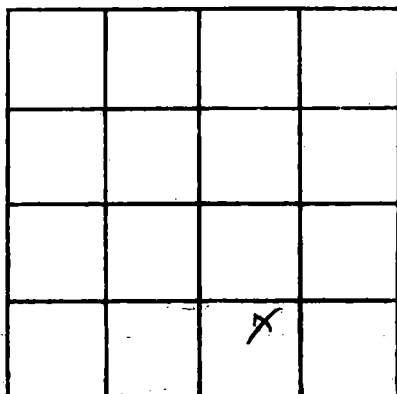

SECTION 6

Please indicate well location X.

ADDITIONAL INFORMATION

If more than one screen,  
show locations of each on sketch.