

JACKSON
H 41
7-12-74

MISSISSIPPI
BOARD OF WATER COMMISSIONERS
416 North State Street
Jackson, Mississippi 39201
WATER WELL DRILLERS LOG

CODED

July 12 1974 Colville Water Log Jackson
date well completed firm name county well located

LANDOWNER: Bush
Lure
Big Point Ms.
(mailing address)

description of formations encountered	from	to
clay	0	20
sand	20	66
clay	66	220
sand	220	226

WELL LOCATION:
sec. 33 T 5 N R 5 E
12 miles NE of MP
(distance) (direction) (nearest town)

WELL PURPOSE: Home
(home, irrigation, municipal, industrial)

WELL COMPLETION DATA:

(1) diameter (inches) 2

(2) total depth (feet) 226

(3) static water level (feet) 18'-3" below top of ground

(4) casing Plastic 221
(material) (depth)

(size) If telescope see back.

(5) screen 5' 221
(length) (depth to top)

2 plastic
(size) (material)

(6) pump 1/2 10
(HP) (yield gpm)

dea
(type power)

(7) electric log no
(yes or no)

(organization running log)

(8) how well bottom plugged B.P. Veloc

CODED


RECEIVED

SEP 20 1974

DRILLERS REMARKS:

If well telescopes please sketch and show depths.

GROUND LEVEL

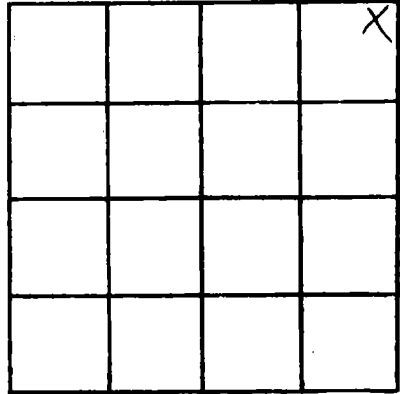

SECTION 33

Please indicate well location X.

ADDITIONAL INFORMATION

If more than one screen, show locations of each on sketch.