

JACKSON
H 42
8-10-74

MISSISSIPPI
BOARD OF WATER COMMISSIONERS
416 North State Street
Jackson, Mississippi 39201

CODED

WATER WELL DRILLERS LOG

Aug 10 1974 Polville Underdog Jackson
date well completed firm name county well located

LANDOWNER: Kenneth Bell
Big Point Ms.
(mailing address)

WELL LOCATION:
sec. 23 T 5 N R 5 E
14 miles NE of MP
(distance) (direction) (nearest town)

WELL PURPOSE: Home
(home, irrigation, municipal, industrial)

WELL COMPLETION DATA:
(1) diameter (inches) 2
(2) total depth (feet) 320
(3) static water level (feet) 3 below top of ground
(4) casing plastic (material) (depth)
(size) if telescope see back.
(5) screen 5 315 (length) (depth to top)
(size) (material)
(6) pump 1/3 10 (HP) (yield gpm)
(type power) elec
(7) electric log no (yes or no)
(organization running log)
(8) how well bottom plugged B.P. Underdog

description of formations encountered	from	to
	0	20
	20	65
	65	120
	120	154
	154	305
	305	320

CODED


RECEIVED

SEP 30 1974

DRILLERS REMARKS:

If well telescopes please sketch and show depths.

GROUND LEVEL

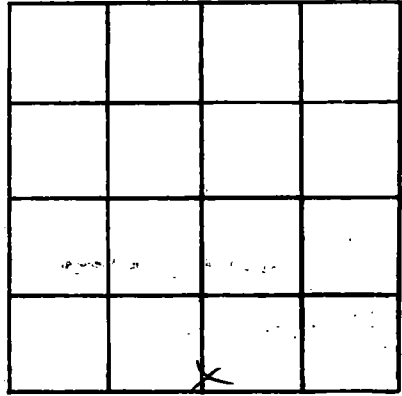

SECTION 23

Please indicate well location X.

ADDITIONAL INFORMATION

If more than one screen, show locations of each on sketch.