

JACKSON
H43
7-20-74

MISSISSIPPI
BOARD OF WATER COMMISSIONERS
416 North State Street
Jackson, Mississippi 39201

CODED

WATER WELL DRILLERS LOG

July 20 1974 Colville Water Sup Jackson
date well completed firm name county well located

LANDOWNER: <u>Gerry Egan</u>	description of formations encountered	from	to
<u>Bay Point MS</u> (mailing address)	<u>Clay sand</u>	<u>2</u>	<u>20</u>
WELL LOCATION: sec <u>33</u> T <u>5</u> N R <u>5</u> E <u>1 1/2</u> miles <u>NE</u> of <u>M.P.</u> (distance) (direction) (nearest town)	<u>black sand</u>	<u>66</u>	<u>200</u>
WELL PURPOSE: <u>Home</u> (home, irrigation, municipal, industrial)			
WELL COMPLETION DATA:			
(1) diameter (inches) <u>2</u>			
(2) total depth (feet) <u>226</u>			
(3) static water level (feet) <u>18-3</u> ^{below} _{above} top of ground			
(4) casing <u>plastic 221</u> (material) (depth)			
_____ if telescope see back. (size)			
(5) screen <u>5</u> <u>221</u> (length) (depth to top)			
<u>2</u> <u>plastic</u> (size) (material)			
(6) pump <u>1/2</u> <u>10</u> (HP) (yield gpm)			
<u>elec</u> (type power)			
(7) electric log <u>no</u> (yes or no)			
_____ (organization running log)			
(8) how well bottom plugged <u>BP valve</u>			
DRILLERS REMARKS:			


CODED

RECEIVED

SEP 20 1974

If well telescopes please sketch and show depths.

GROUND LEVEL

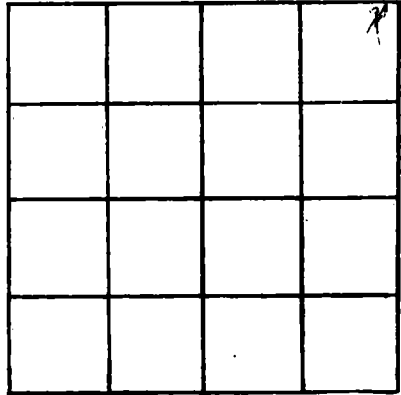

SECTION 37

Please indicate well location X.

ADDITIONAL INFORMATION

A series of horizontal lines for writing additional information, starting below the 'ADDITIONAL INFORMATION' header and extending to the bottom of the page.

If more than one screen, show locations of each on sketch.