

Jackson

H 44

11-15-74

MISSISSIPPI BOARD OF WATER COMMISSIONERS
416 North State Street
Jackson, Mississippi 39201

CODED

WATER WELL DRILLERS LOG

Nov 15 1974
date well completed

firm name

county well located

LANDOWNER: Robert Shickle

description of formations encountered

from

to

Rt. 2 Box 331

red sand clay

0' 22'

Paragould Miss.
(mailing address)

white sand w/
white clay streaks

22'

WELL LOCATION:

sec. 7 T. 5 N. R. 4 E.
4 miles east of Hinkley
(distance) (direction) (nearest town)

white coarse sand

35' 51'

WELL PURPOSE: Home
(home, irrigation, municipal, industrial)

WELL COMPLETION DATA:

- (1) diameter (inches) 2 1/2"
- (2) total depth (feet) 51'
- (3) static water level (feet) 26' below top of ground
- (4) casing PVC 47' (material) (depth)
(size) If telescope see back.
- (5) screen 4" 47' (length) (depth to top)
2 1/2" PVC (size) (material)
- (6) pump 1 12 (HP) (yield gpm)
elc (type power)
- (7) electric log no (yes or no)
(organization running log)
- (8) how well bottom plugged R.W.L.

CODED

RECEIVED


DEC 19 1974

MISS. BD. OF WATER COMM.

DRILLERS REMARKS:

If well telescopes please sketch and show depths.

GROUND LEVEL

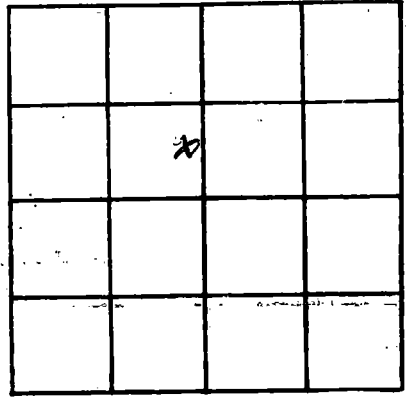

SECTION 2

Please indicate well location X.

ADDITIONAL INFORMATION

Lined area for additional information.

If more than one screen, show locations of each on sketch.