

MISSISSIPPI DEPARTMENT OF NATURAL RESOURCES

Bureau of Land and Water Resources

Southport Mall

P.O. Box 10631

CODED.

Jackson, Mississippi 39209
WATER WELL DRILLERS LOG

H-45
 JACKSON CO
 10-21-84

0-21-84 19 ~~10-21-84~~ Injoke well JACKSON
 date well completed firm name Swice county well located

LANDOWNER: David West
P.O. Box 72
Huska, MS 39555
 (mailing address)
 WELL LOCATION:
 sec. 1 T 5 N R. 5 E
1 miles N of Big Point
 (distance) (direction) (nearest town)

description of formations encountered	from	to
<u>Top Soil + Clay</u>	<u>0</u>	<u>10</u>
<u>Sandy Clay</u>	<u>10</u>	<u>20</u>
<u>Sand</u>	<u>20</u>	<u>60</u>
<u>Clay</u>	<u>60</u>	<u>420</u>
<u>Thin Sand</u>	<u>42</u>	<u>430</u>
<u>med Sand</u>	<u>450</u>	<u>470</u>

WELL PURPOSE:
 (home) Irrigation, municipal, industrial


WELL COMPLETION DATA:
 (1) diameter (inches) 2"
 (2) total depth (feet) 470
 (3) static water level (feet) 160
 top of ground.
 (4) casing PVC
 (material) (depth)
1 1/2" if telescope see back.
 (size)
 (5) screen 10' 460'
 (length) (depth to top)
2" #8 PVC
 (size) (material)
 (6) pump LHB 8
 (HP) (yield gpm)
Elect
 (type power)
 (7) electric log no
 (yes or no)
no
 (organization running log)
 (8) how well bottom plugged PVC
Ball Valve

DRILLERS REMARKS: good well

1-17-85
2/2/85

If well telescopes please sketch and show depths.

GROUND LEVEL

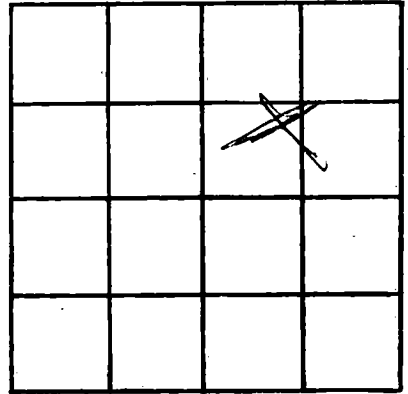

SECTION 21

Please indicate well location X.

ADDITIONAL INFORMATION

If more than one screen, show locations of each on sketch.