

Jackson
 H046
 3-4-86

MISSISSIPPI
 BOARD OF WATER COMMISSIONERS
 416 North State Street
 Jackson, Mississippi 39201

CODED

WATER WELL DRILLERS LOG

3-4 date well completed
 De Perce Drilling Co. firm name
 Jackson county well located

LANDOWNER: Albert Greenough
Pascagoula, ms
 (mailing address)

WELL LOCATION:
 sec. 26 T. 5 N. R. 5 E.
2 miles East of Big Point
 (distance) (direction) (nearest town)

WELL PURPOSE:
 (home) irrigation, municipal, industrial)

WELL COMPLETION DATA:
 (1) diameter (inches) 2"
 (2) total depth (feet) 440'
 (3) static water level (feet) 10 below top of ground above
 (4) casing plastic 430'
 (material) (depth)
0 if telescope see back. 430'
 (size)
 (5) screen 10' 1140
 (length) (depth to top)
006 plastic
 (size) (material)
 (6) pump 0 0
 (HP) (yield gpm)
electric
 (type power)
 (7) electric log (yes or no)
 (organization running log)
 (8) how well bottom plugged BW


description of formations encountered	from	to
Top soil	0	15
Clay	15	20
Good Sand	20	25
Clay	25	140
Good Sand	140	160
Clay	160	205
Good Sand	205	225
Clay	225	400
Good Sand	400	440

DRILLERS REMARKS: Free Flowing
25 GPM

RECEIVED
 MAR 19 1986

If well telescopes please sketch and show depths.

GROUND LEVEL

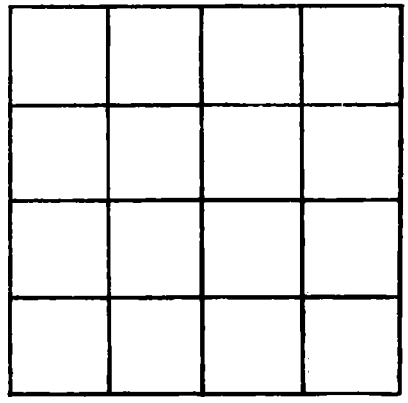

SECTION _____

Please indicate well location X.

ADDITIONAL INFORMATION

A series of horizontal lines for providing additional information.

If more than one screen, show locations of each on sketch.