

JACKSON
H47

MISSISSIPPI
BOARD OF WATER COMMISSIONERS
416 North State Street
Jackson, Mississippi 39201

CODED

WATER WELL DRILLERS LOG

8-5-1986 date well completed
Pierce Drilling Co. firm name
Jackson county well located

LANDOWNER: Big Point Meth Church

description of formations encountered	depth	
	from	to
20' soil	0	10
clay	10	20
good sand	20	75

Big Point ms
(mailing address)

WELL LOCATION:
sec. 28 T. 5 N. R. 5 E
1/2 miles east of Big Point
(distance) (direction) (nearest town)

WELL PURPOSE: Church
(home, irrigation, municipal, industrial)

- WELL COMPLETION DATA:
- (1) diameter (inches) 2"
 - (2) total depth (feet) 75'
 - (3) static water level (feet) 20' ^{below} above top of ground.
 - (4) casing plastic 70'
(material) (depth)
 - 0 (size) if telescope see back.
 - (5) screen 5' 75'
(length) (depth to top)
 - 006, plastic
(size) (material)
 - (6) pump 1 12
(HP) (yield gpm)
 - electric
(type power)
 - (7) electric log (yes or no)
 - (organization running log)
 - (8) how well bottom plugged BU

CODED

RECEIVED


AUG 11 1986

DRILLERS REMARKS:

Department of Natural Resources
Bureau of Land & Water Resources

If well telescopes please sketch and show depths.

GROUND LEVEL

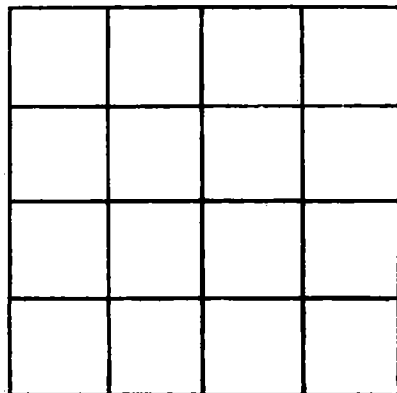

SECTION _____

Please indicate well location X.

ADDITIONAL INFORMATION

If more than one screen, show locations of each on sketch.