

MISSISSIPPI DEPARTMENT OF NATURAL RESOURCES

Bureau of Land and Water Resources

P.O. Box 10631

Jackson, Mississippi 39209

WATER WELL DRILLERS LOG

COUNTY WELL LOCATED
SACKSON
WELL NUMBER ICODED
H49
DATE WELL COMPLETED
10-26-87

PERMIT NUMBER
Fry Fork well
NAME OF DRILLING FIRM
RT 8, Box 3
Lucedale, MS

CODED

NAME & MAILING ADDRESS OF LANDOWNER
Joe Farr
WELL LOCATION: SEC **33** TOWNSHIP **18 N** RANGE **15 E**
Big Point
DISTANCE **2** Miles **South** of **Big Point**
OTHER LANDMARK
WELL PURPOSE Home Irrigation, Municipal, Industrial, Fish Pond, etc.

PUMP DATA
PUMP TYPE (Circle One):
Submersible, Turbine, **Jet** Flowing Well, Other (Describe) _____
POWER TYPE (Circle One):
Electric, Tractor, Diesel, Gasoline, Butane, Other (Describe) _____
PUMP TEST
Pump Capacity (GPM) **10** No. of Stages **2** Setting Depth **20** FT.
Well yielded **0** GPM with
a drawdown of **0** ft.
after **10-min** hours of pumping

CODED

WELL DATA
Well Depth **107** Casing Diameter (In.) **2"** Casing Length (Ft.) **103**
Type of Casing **PVC** Hole Depth **107** Depth to Static Water Level **Over Flow**
TYPE OF COMPLETION: (Circle One or More):
 Gravel Packed, Underreamed, Telescoped,
 Natural Development, Open Hole, Other
Top of Lap Pipe or Reduction in Casing
FEET IF TELESCOPED OR MORE THAN ONE SCREEN: USE BACK PAGE

LOG DATA
TYPE OF LOG RUN (Circle One):
No Log Run, Electric, Gamma Ray, Density, Sonic, Neutron, Other (Describe) _____
Name of Organization Running Log

SCREEN DATA
Diameter - Inches **2"** Length - Feet **5'** Slot Size - Inches **#8**
Screen Type **Sound PVC** Depth to Bottom - Feet **107**

GEOLOGIC DATA (Office Use Only)

Surface Elev.	Geologic Unit	Unit Thickness	Depth to Top
Subs. SWL	Date	Analysis	Aquifer Test

Driller's Remarks
Extra good well

RECEIVED

DESCRIPTION OF FORMATIONS ENCOUNTERED	FROM	TO	FORMATIONS (Continued)	FROM	TO
Tap Soil	0	5			
Sand	5	30			
Blue Clay	30	80			
Fine Sand	80	95			
Coarse Sand	95	107			


IF MORE SPACE IS NEEDED: USE BACK

AUG 18 1987

Department of Natural Resources
Bureau of Land & Water Resources

If well telescopes please sketch and show depths.

GROUND LEVEL

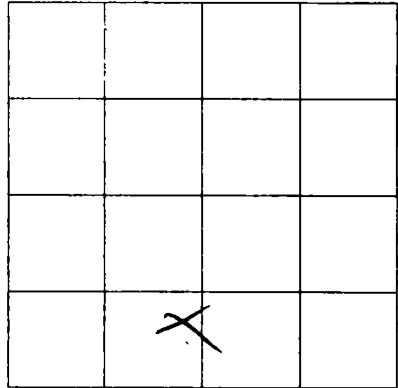

SECTION 33

Please indicate well location X.

ADDITIONAL INFORMATION

If more than one screen,
show location of each on sketch.