

MISSISSIPPI DEPARTMENT OF ENVIRONMENTAL QUALITY

Office of Land and Water Resources

COUNTY WELL LOCATED
Jackson

WELL NUMBER CODED
H 53

DATE WELL COMPLETED
12-19-92

PERMIT NUMBER

NAME OF DRILLING FIRM
Coast Water Well Ser Inc.

P. O. Box 10631
Jackson, MS 39289-0631
WATER WELL DRILLERS LOG

NAME & MAILING ADDRESS OF LANDOWNER
Garry Shumock

WELL LOCATION: SEC *25* TOWNSHIP *5 N* RANGE *5 E*

DISTANCE *1* Miles DIRECTION *NE* of NEAREST TOWN *Big Point*

OTHER LANDMARK

WELL PURPOSE: Home, Irrigation, Municipal, Industrial, Fish Pond, etc.

PUMP DATA

PUMP TYPE (Circle One):
Submersible, Turbine, Jet, Flowing Well.
Other (Describe)

POWER TYPE (Circle One):
Electric, Tractor, Diesel, Gasoline, Butane.
Other (Describe) H/P

Pump Capacity (GPM) No. of Stages Setting Depth FT.

PUMP TEST
Well yielded _____ GPM with
a drawdown of _____ ft.
after _____ hours of pumping

WELL DATA

Well Depth <i>594'</i>	Casing Diameter (In.) <i>2"</i>	Casing Length (Ft.) <i>580'</i>
Type of Casing <i>PVC</i>	Hole Depth <i>594'</i>	Depth to Static Water Level <i>Flow'</i>

TYPE OF COMPLETION: (Circle One or More):
Gravel Packed, Underreamed, Telescoped,
Natural Development, Open Hole, Other
(Describe)

LOG DATA

TYPE OF LOG RUN (Circle One): No Log Run.
Electric, Gamma Ray, Density, Sonic, Neutron,
Other (Describe)

Name of Organization Running Log

WELL GROUTED TO A DEPTH OF _____ FEET
Type Grout (circle one): Cement, Bentonite, or Mix

GEOLOGIC DATA (Office Use Only)

Surface Elev.	Geologic Unit	Unit Thickness	Depth to Top
Subs. SWL	Date	Analysis	Aquifer Test

SCREEN DATA

Diameter - Inches <i>2"</i>	Length - Feet <i>10'</i>	Slot Size - Inches <i>.008</i>
Screen Type <i>PVC</i>	Depth to Bottom - Feet <i>590'</i>	

Driller's Remarks


DESCRIPTION OF FORMATIONS ENCOUNTERED	FROM	TO	FORMATIONS (Continued)	FROM	TO
<i>Top soil</i>	<i>0</i>	<i>2</i>	<i>Blue Clay</i>	<i>590</i>	<i>594</i>
<i>Red Clay</i>	<i>2</i>	<i>10</i>			
<i>Coarse sand & gravel</i>	<i>10</i>	<i>100</i>			
<i>Blue Clays w/ sand & gravel</i>	<i>100</i>	<i>395</i>			
<i>fine to med sand</i>	<i>395</i>	<i>425</i>			
<i>Blue Clay</i>	<i>425</i>	<i>455</i>			
<i>fine sand</i>	<i>455</i>	<i>460</i>			
<i>Blue Clay</i>	<i>460</i>	<i>475</i>			
<i>fine sand</i>	<i>475</i>	<i>482</i>			
<i>Blue Clays w/ sand</i>	<i>482</i>	<i>555</i>			
<i>med coarse sand</i>	<i>555</i>	<i>590</i>			

RECEIVED

JAN 27 1993

If well telescopes please sketch and show depths.

GROUND LEVEL

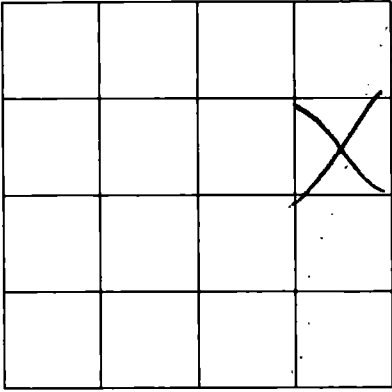

SECTION _____

Please indicate well location X.

ADDITIONAL INFORMATION

Lined area for additional information.

If more than one screen, show location of each on sketch.