

MISSISSIPPI DEPARTMENT OF ENVIRONMENTAL QUALITY

Office of Land and Water Resources

P. O. Box 10631
Jackson, MS 39289-0631
WATER WELL DRILLERS LOG

COUNTY WELL LOCATED
Jackson

WELL NUMBER *H 63* CODED

DATE WELL COMPLETED
12-23-94

PERMIT NUMBER

NAME OF DRILLING FIRM
Coast Water Well Service

NAME & MAILING ADDRESS OF LANDOWNER
George White
Horace Shumock Rd.
Pascagoula, Ms.

WELL LOCATION SEC *28* TOWNSHIP *5 S* RANGE *5 W*

DISTANCE *5* Miles DIRECTION *SOUTH* of NEAREST TOWN *Hurley*

OTHER LANDMARK *NE SE*

WELL PURPOSE: Home, Irrigation, Municipal, Industrial, Fish Pond, etc

PUMP DATA

PUMP TYPE (Circle One):
Submersible, Turbine, Jet, Flowing Well,
Other (Describe) _____

POWER TYPE (Circle One):
 Electric, Tractor, Diesel, Gasoline, Butane,
Other (Describe) _____ H/P *1*

Pump Capacity (GPM) *12* No. of Stages *2* Setting Depth _____ FT.

PUMP TEST
Well yielded _____ GPM with
a drawdown of _____ ft.
after _____ hours of pumping

WELL DATA

Well Depth <i>382'</i>	Casing Diameter (in.) <i>2"</i>	Casing Length (Ft.) <i>372'</i>
Type of Casing <i>PVC</i>	Hole Depth <i>382'</i>	Depth to Static Water Level <i>20'</i>

TYPE OF COMPLETION: (Circle One or More):
Gravel Packed, Underreamed, Telescoped,
 Natural Development, Open Hole, Other _____
(Describe) _____

WELL GROUTED TO A DEPTH OF *20* FEET
Type Grout (circle one): Cement, Bentonite, or Mix

LOG DATA

TYPE OF LOG RUN (Circle One): No Log Run,
Electric, Gamma Ray, Density, Sonic, Neutron,
Other (Describe) _____

Name of Organization Running Log _____

SCREEN DATA

Diameter - Inches <i>2"</i>	Length - Feet <i>10'</i>	Slot Size - Inches <i>.008</i>
Screen Type <i>PVC</i>	Depth to Bottom - Feet <i>382'</i>	

Top of Lap Pipe or Reduction in Casing _____ FEET

IF TELESCOPED OR MORE THAN ONE SCREEN: USE BACK PAGE

GEOLOGIC DATA (Office Use Only)

Surface Elev.	Geologic Unit	Unit Thickness	Depth to Top
Subs. SWL	Date	Analysis	Aquifer Test

Driller's Remarks _____

DESCRIPTION OF FORMATIONS ENCOUNTERED	FROM	TO	FORMATIONS (Continued)	
			FROM	TO
<i>Stratified Clay</i>	<i>0</i>	<i>17</i>		
<i>White Coarse Sand</i>	<i>17</i>	<i>64</i>		
<i>White Clay</i>	<i>64</i>	<i>70</i>		
<i>White Coarse Sand</i>	<i>70</i>	<i>129</i>		
<i>Blue Clay w/ Shale</i>	<i>129</i>	<i>359</i>		
<i>Grey fine sand</i>	<i>359</i>	<i>367</i>		
<i>Grey Medium Sand</i>	<i>367</i>	<i>382</i>		

RECEIVED


JAN 11 1995

Dept. of Environmental Quality
Office of Land & Water Resources

IF MORE SPACE IS NEEDED, USE BACK

If well telescopes please sketch and show depths.

GROUND LEVEL

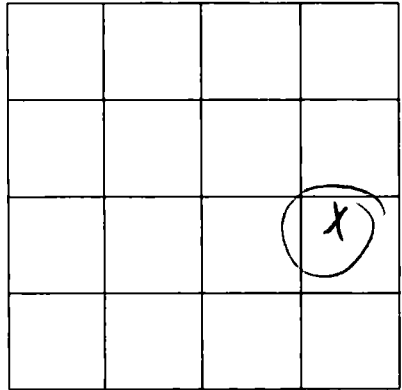

SECTION 28

Please indicate well location X.

ADDITIONAL INFORMATION

If more than one screen,
show location of each on sketch.