

✓ #3

MISSISSIPPI DEPARTMENT OF ENVIRONMENTAL QUALITY

Office of Land and Water Resources

P. O. Box 10631  
Jackson, MS 39289-0631  
WATER WELL DRILLERS LOG

COUNTY WELL LOCATED <i>Jackson</i>	
WELL NUMBER <i>H 65</i>	CODED
DATE WELL COMPLETED <i>6-17-96</i>	

PERMIT NUMBER
NAME OF DRILLING FIRM <i>Coast Water Well Service</i>

NAME & MAILING ADDRESS OF LANDOWNER <i>Kerry Ray Lilly Orchard Rd. Pascagoula, Ms.</i>			
WELL LOCATION	SEC	TOWNSHIP	RANGE
	<i>27</i>	<i>5</i>	<i>5</i>
DISTANCE	DIRECTION	NEAREST TOWN	
<i>1</i> Miles	<i>EAST</i>	<i>Big Point</i>	
OTHER LANDMARK			
WELL PURPOSE <input checked="" type="checkbox"/> Home Irrigation, <input type="checkbox"/> Municipal, <input type="checkbox"/> Industrial, <input type="checkbox"/> Fish Pond, etc.			

PUMP DATA		
PUMP TYPE (Circle One): Submersible, Turbine, <input checked="" type="radio"/> Jet, Flowing Well, Other (Describe) _____		
POWER TYPE (Circle One): <input checked="" type="radio"/> Electric, <input type="radio"/> Tractor, <input type="radio"/> Diesel, <input type="radio"/> Gasoline, <input type="radio"/> Butane, Other (Describe) _____ H/P <i>1/2</i>		
Pump Capacity (GPM) <i>8</i>	No. of Stages <i>1</i>	Setting Depth  FT.
PUMP TEST  Well yielded _____ GPM with a drawdown of _____ ft. after _____ hours of pumping		

WELL DATA		
Well Depth <i>70'</i>	Casing Diameter (In.) <i>2"</i>	Casing Length (Ft.) <i>65'</i>
Type of Casing <i>PVC</i>	Hole Depth <i>70'</i>	Depth to Static Water Level <i>5'</i>

LOG DATA	
TYPE OF LOG RUN (Circle One): Electric, Gamma Ray, Density, Sonic, <input checked="" type="radio"/> No Log Run, Neutron, Other (Describe) _____	
Name of Organization Running Log	

TYPE OF COMPLETION: (Circle One or More): <input checked="" type="checkbox"/> Gravel Packed, <input type="checkbox"/> Underreamed, <input type="checkbox"/> Telescoped, <input checked="" type="checkbox"/> Natural Development, <input type="checkbox"/> Open Hole, <input type="checkbox"/> Other (Describe) _____	
WELL GROUTED TO A DEPTH OF <i>20</i> FEET Type Grout (circle one): Cement, <input checked="" type="checkbox"/> Bentonite, or Mix	

GEOLOGIC DATA (Office Use Only)			
Surface Elev.	Geologic Unit	Unit Thickness	Depth to Top
Subs. SWL	Date	Analysis	Aquifer Test

SCREEN DATA		
Diameter - inches <i>2"</i>	Length - Feet <i>5'</i>	Slot Size - inches <i>.008</i>
Screen Type <i>PVC</i>	Depth to Bottom - Feet <i>70'</i>	


Driller's Remarks	
Top of Lap Pipe or Reduction in Casing  FEET <input type="checkbox"/> IF TELESCOPED OR MORE THAN ONE SCREEN: USE BACK PAGE	

DESCRIPTION OF FORMATIONS ENCOUNTERED	FROM	TO
<i>Top Soil</i>	<i>0</i>	<i>2</i>
<i>White Coarse sand</i>	<i>2</i>	<i>45</i>
<i>Red Clay</i>	<i>45</i>	<i>50</i>
<i>White Coarse sand</i>	<i>50</i>	<i>70</i>

FORMATIONS (Continued)	FROM	TO
<b>RECEIVED</b>		
<b>AUG 28 1996</b>		
Dept. of Environmental Quality Office of Land & Water Resources		
IF MORE SPACE IS NEEDED, USE BACK		

If well telescopes please sketch and show depths.

GROUND LEVEL

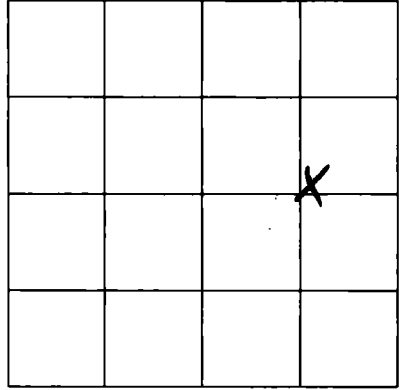

SECTION 27

Please indicate well location X.

ADDITIONAL INFORMATION

If more than one screen,  
show location of each on sketch.