

**MISSISSIPPI DEPARTMENT OF ENVIRONMENTAL QUALITY**

Office of Land and Water Resources

P. O. Box 10631  
Jackson, MS 39289-0631  
**WATER WELL DRILLERS LOG**

COUNTY WELL LOCATED <i>Jackson</i>	
WELL NUMBER <i>H 70</i>	CODED
DATE WELL COMPLETED <i>3-24-99</i>	

PERMIT NUMBER
NAME OF DRILLING FIRM <i>Coast Water Well Service</i>

NAME & MAILING ADDRESS OF LANDOWNER <i>Johnny Martin</i>			
<i>Pipeline Rd.</i>			
<i>Passagoula, Ms</i>			
WELL LOCATION	SEC	TOWNSHIP	RANGE
	<i>30</i>	<i>5<sup>th</sup></i>	<i>5<sup>th</sup></i>
DISTANCE	DIRECTION	NEAREST TOWN	
<i>2 1/2</i> Miles	<i>West</i>	of <i>Bipoint</i>	
OTHER LANDMARK			
WELL PURPOSE <input checked="" type="radio"/> Home Irrigation, <input type="radio"/> Municipal, <input type="radio"/> Industrial, <input type="radio"/> Fish Pond, etc.			

PUMP DATA		
PUMP TYPE (Circle One): Submersible, Turbine, <input checked="" type="radio"/> Jet, Flowing Well, Other (Describe) _____		
POWER TYPE (Circle One): <input checked="" type="radio"/> Electric, Tractor, Diesel, Gasoline, Butane, Other (Describe) _____ <i>H/P 1</i>		
Pump Capacity (GPM) <i>8</i>	No. of Stages <i>2</i>	Setting Depth  <b>FT.</b>
PUMP TEST		
Well yielded _____ GPM with a drawdown of _____ ft. after _____ hours of pumping		

WELL DATA		
Well Depth <i>715'</i>	Casing Diameter (In.) <i>2"</i>	Casing Length (Ft.) <i>705'</i>
Type of Casing <i>PVC</i>	Hole Depth <i>715'</i>	Depth to Static Water Level <i>1'</i>
TYPE OF COMPLETION: (Circle One or More): <input checked="" type="radio"/> Gravel Packed, <input type="radio"/> Underreamed, <input type="radio"/> Telescoped, <input checked="" type="radio"/> Natural Development, <input type="radio"/> Open Hole, <input type="radio"/> Other (Describe) _____		
WELL GROUTED TO A DEPTH OF <i>20</i> FEET Type Grout (circle one): <input checked="" type="radio"/> Cement, <input type="radio"/> Bentonite, or <input type="radio"/> Mix		

LOG DATA	
TYPE OF LOG RUN (Circle One): Electric, Gamma Ray, Density, Sonic, <input checked="" type="radio"/> Neutron, Other (Describe) _____	
Name of Organization Running Log	

SCREEN DATA		
Diameter - Inches <i>2"</i>	Length - Feet <i>10'</i>	Slot Size - Inches <i>.004</i>
Screen Type <i>PVC Wrapped</i>	Depth to Bottom - Feet <i>715'</i>	


GEOLOGIC DATA (Office Use Only)			
Surface Elev.	Geologic Unit	Unit Thickness	Depth to Top
Subs. SWL	Date	Analysis	Aquifer Test
Driller's Remarks			

DESCRIPTION OF FORMATIONS ENCOUNTERED	FROM	TO
<i>Top Soil</i>	<i>0</i>	<i>3</i>
<i>Blown Clay</i>	<i>3</i>	<i>12</i>
<i>Med Coarsed sand shell</i>	<i>12</i>	<i>80</i>
<i>White gray blud lay shell</i>	<i>80</i>	<i>680</i>
<i>Rock</i>	<i>320</i>	
<i>Rock</i>	<i>356</i>	
<i>Rock</i>	<i>360</i>	
<i>Rock</i>	<i>428</i>	
<i>Med Sand &amp; shell</i>	<i>680</i>	<i>700</i>
<i>Coarse sand &amp; shell</i>	<i>700</i>	<i>715</i>

FORM TO BE COMPLETED FROM TO	
<b>RECEIVED</b>	
APR 12 1999	
Dept. of Environmental Quality Office of Land & Water Resources	
IF MORE SPACE IS NEEDED, USE BACK	

If well telescopes please  
sketch and show depths.

GROUND LEVEL

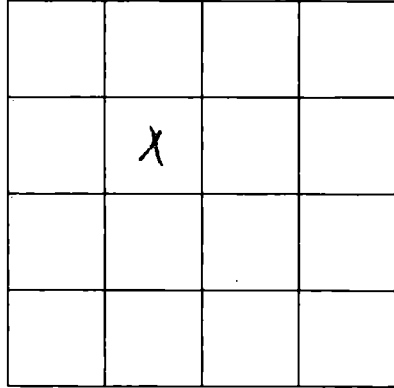

SECTION 30

Please indicate well location X.

ADDITIONAL INFORMATION

If more than one screen,  
show location of each on sketch.