

# State Well Report

## Part 1

Mississippi Department of Environmental Quality  
 Office of Land and Water Resources  
 P.O. Box 10631  
 Jackson, MS 39289-0631  
 (601)961-5210  
 (601)354-6938 (fax)

### For Office Use Only:

Aquifer: \_\_\_\_\_  
 Well #: H-114  
 L. S. Elevation: \_\_\_\_\_  
 E-log #: \_\_\_\_\_

County: Jackson  
 Permit #: \_\_\_\_\_  
 Driller: Coast Water Well Serv  
 Date drilling completed: 6-27-05

State Law requires that this report be prepared by the driller in detail and filed with the Department within 30 days of completion of drilling of the well.

Well Owner Information	Well Location
Owner Name: <u>Gary Bell</u>	Latitude: <u>30° 35' 55.2"</u> Longitude: <u>88° 27' 54.5"</u>
Mailing Address: <u>17371 Rayford Shumock RD</u>	Method of Lat/Long (circle one): Conventional Survey, <u>33</u>
<u>MOSS POINT MS 39562</u>	USGS quad: <u>(Hand-held GPS)</u> Survey-grade GPS
City State Zip Code	<u>SW 1/4 SW 1/4 Sec 23 Twn 155 Rng R5W</u>
Telephone No. <u>(601) 588-6185</u>	Distance Direction Nearest Town
	<u>1 1/2 Miles EAST of Big Point</u>

### Well Data

Purpose of Well (circle one) Home Industrial Public Supply Irrigation Fish Culture Other: \_\_\_\_\_

Date well drilling started: 6-27-05 Date well drilling completed: 6-27-05

If flowing, method of flow regulation: Valve N/A Other (describe) \_\_\_\_\_

Static Water Level: 1 feet above or below (circle one) land surface Date measured: 6-27-05

Method of Measurement (circle one) steel tape electric tape air line other: \_\_\_\_\_

Hole depth: 444' Well depth: 444' Well grouted to a depth of 10 feet

Type of grout (circle one): Cement Bentonite Mix

Casing length: 434 feet Casing diameter: 2 inches Type of casing: PVC

Screen length: 10 feet Screen diameter: 2 inches Type of screen: PVC

Screen slot size: .004 inches Setting depth: From 434 feet to 444 feet

Type of completion (circle all applicable): Gravel packed Underreamed Telescoped Open hole Natural Development

Other (describe): \_\_\_\_\_

Top of lap pipe or reduction in casing: N/A feet. If telescoped or more than one screen, describe on back of page

Logs run (circle all applicable): No log run Electric Gamma Ray Density Sonic Neutron Other: \_\_\_\_\_

Name of organization running log(s): N/A

I certify that the well was drilled, constructed, and completed in accordance with all applicable requirements of the Mississippi Department of Environmental Quality and/or the Mississippi Department of Health regulations and state laws.

Jack Ridgdell 0-472  
 Print Name of Water Well Contractor and License No.

Jack Ridgdell  
 Signature of Water Well Contractor

RECEIVED


JUL 25 2005

BY: OLWR

If well telescopes please sketch below and show depths.

H-114


Ground Level

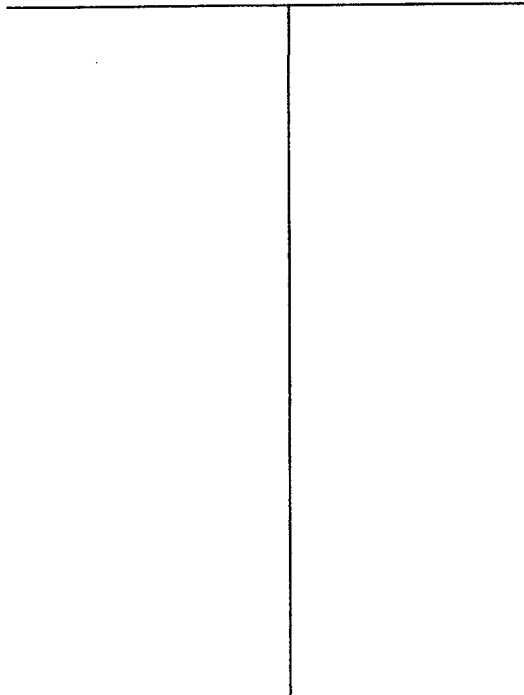

Description of Formations Encountered	From	To
Top Soil	0	3
White coarse sand w/STR OF clay	3	90
Blue clay w/streaks of sand	90	417
Gray Medium to coarse sand	417	444

If more than one screen, show location of each on sketch

Sketch the property layout and include the following: 1) the well location; 2) any permanent structures on the property that may aid in locating the well; 3) any roads, power lines, or other items that may aid in locating the property and the well; 4) indicate direction.

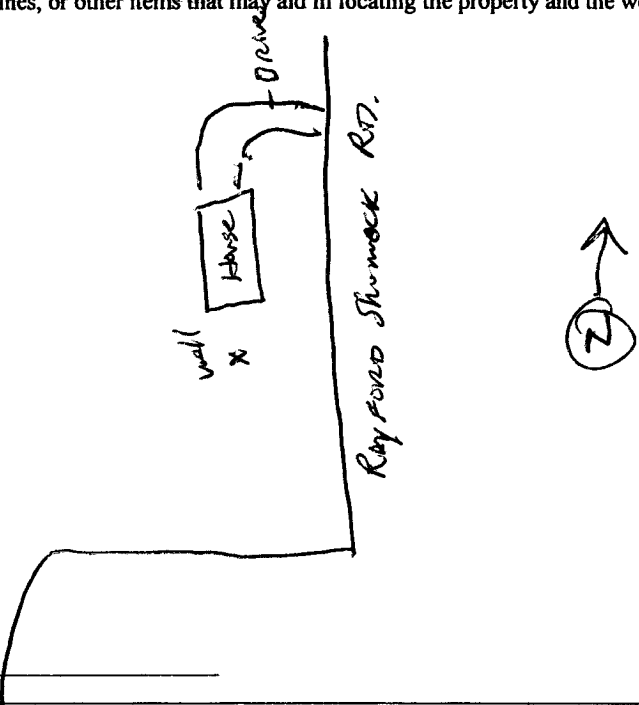

Landowner Name: Gary Bell

*Gary Bell*  
 Signature of Water Well Contractor

RECEIVED  
 JUL 25 2005  
 BY: OLWR

# STATE WELL REPORT

## Part 2

**Pump Installer's Completion Report**  
 Mississippi Department of Environmental Quality  
 Office of Land and Water Resources  
 P.O. Box 10631  
 Jackson, MS 39289-0631  
 (601)961-5210  
 (601)354-6938 (fax)

County: Jackson  
 Permit #: \_\_\_\_\_  
 Driller: Coast Water Wells Srvc  
 Date completed: 6-27-05

**For Office Use Only:**

Aquifer: \_\_\_\_\_  
 Well #: H-114  
 Elevation: \_\_\_\_\_

**This report should be prepared by the pump installer in detail and filed with the Department within 30 days of the installation of pump.**

Well Owner Information	Well Location
Owner Name: <u>Gary Bell</u>	Latitude: <u>30°35'55.2"</u> Longitude: <u>088°27'54.5"</u>
Mailing Address: <u>17371 Rayford Shumock RD</u>	Method of Lat/Long (circle one): Conventional Survey, USGS quad, <u>(Hand-held GPS)</u> Survey-grade GPS
<u>Mass Point MS 39562</u> City State Zip Code	<u>SW 1/4 SW 1/4 Sec 23 Twn T5S Rng R5W</u>
Telephone No. <u>601 588-6185</u>	Distance Direction Nearest Town <u>1 1/2 Miles EAST of Big Point</u>

Pump Type Circle one	Power Type Circle one
Air Lift <input type="radio"/> Jet <input checked="" type="radio"/> Submersible	Diesel Engine Gasoline Engine Natural Gas
Bucket <input type="radio"/> Piston <input type="radio"/> Turbine	<u>Electric Motor</u> <input checked="" type="radio"/> Hand <input type="radio"/> Tractor PTO
Centrifugal <input type="radio"/> Rotary <input type="radio"/> Flowing Well	Windmill Other (specify): _____
Other (specify): _____	Horse Power Rating of Motor: <u>1/2 HP SNC</u>
Date Pump Installed: <u>6-29-05</u>	Setting Depth: <u>30 FT Droppipe</u> feet
Rated Pump Capacity: <u>8.5</u> Gallons Per Minute	Number of Stages: <u>1</u>

Pump Test Data	Method of Measuring Water Level Circle one
Date Well Tested: <u>6-29-05</u>	<u>Air Line</u> <input checked="" type="radio"/> Electric Measuring Line <input type="radio"/> Steel Tape <input type="radio"/>
Static Water Level (A): <u>1</u> Feet Below Land Surface	Other (specify): _____
Pumping Water Level (B): <u>N/A</u> Feet Below Land Surface	For flowing well, measured shut in head: <u>N/A</u> feet
Drawdown [(B) - (A)]: <u>N/A</u> Feet Below Land Surface	Well yielded <u>8.5</u> GPM with a drawdown of
Test Pumping Rate: <u>8.5</u> Gallons Per Minute	<u>N/A</u> feet after <u>N/A</u> hours of pumping
Duration of Pump Test (minimum 4 hours): <u>4</u> hours	

I HEREBY CERTIFY that the above statements are true to the best of my knowledge.

John Elkins 0-716P \_\_\_\_\_  
 Print Name of Pump Installer and License No. (if applicable) Signature of Pump Installer

RECEIVED

JUL 25 2005  
 BY: OLWR