

Part 2 never received 3/13

County: Jackson  
 Permit #: 0-780  
 Driller: W. Joel Pierce  
 Date drilling completed: 2-22-07

**State Well Report**  
**Part 1 - Driller's Log**

Mississippi Department of Environmental Quality  
 Office of Land and Water Resources  
 P.O. Box 10631  
 Jackson, MS 39289-0631  
 (601)961-5210  
 (601)354-6938 (fax)

For Office Use Only:  
 Aquifer: \_\_\_\_\_  
 Well #: H-134  
 L. S. Elevation: \_\_\_\_\_  
 E-log #: \_\_\_\_\_

State Law requires that this report be prepared by the license holder responsible for the work and filed with the Department at the above address within 30 days of completion of drilling of the well or borehole.

Information on Well Owner (Landowner if borehole is not for a water well)	Well or Borehole Location
Owner Name: <u>Donna Charlton</u>	Latitude: <u>88° 30' 78" N</u> Longitude: <u>30° 34' 35" W</u>
Mailing Address: <u>5901 Big Point Rd</u>	Method of Lat/Long (circle one): Conventional Survey, <u>23</u>
<u>Miss Point ms 39562</u>	USGS quad: <u>Hand-held GPS</u> Survey-grade GPS
City: _____ State: _____ Zip Code: _____	<u>NE</u> 1/4 <u>NE</u> 1/4 Sec <u>32</u> Twn <u>T5S</u> Rng <u>R5W</u>
Telephone No. <u>(228) 990-3511</u>	Distance: <u>8</u> Miles Direction: <u>South</u> of Nearest Town: <u>Humbly, ms</u>

**Well / Borehole Data**

Date drilling started: 2-22-07 Date drilling completed: 2-22-07 Hole depth: 55 FT Hole diameter: 2

Location of the source of any surface water used for drilling: Aguila ms  
 Method of dosing and volume of Chlorine used in drilling and development: 49 gal chlorine 2000 water

Logs run (circle all applicable): No log run Electric Gamma Ray Density Sonic Neutron Other: \_\_\_\_\_  
 Name of organization running log(s): \_\_\_\_\_

Purpose of borehole (check one): Water Well  Geotechnical/Geological Investigation \_\_\_\_\_ Ground Source Heat Pump \_\_\_\_\_  
 Seismic Survey \_\_\_\_\_ Other (describe) \_\_\_\_\_

*If drilling is not related to water well construction, skip the remainder of this block*

Purpose of Well (check one): Home  Industrial \_\_\_\_\_ Public Supply \_\_\_\_\_ Irrigation \_\_\_\_\_ Fish Culture \_\_\_\_\_ Other: \_\_\_\_\_

If a flowing well, method of flow regulation: Valve \_\_\_\_\_ Other (describe) \_\_\_\_\_

Static Water Level: 5 feet above or below (circle one) land surface Date measured: 2-22-07

Method of Measurement (circle one) steel tape electric tape air line other: \_\_\_\_\_

Well depth: 55 Well grouted to a depth of 10 feet Type of grout (circle one): Neat Cement Bentonite Mix \_\_\_\_\_

Casing length: 50 feet Casing diameter: 2 inches Type of casing: sch 40 Plant

Screen length: 5 feet Screen diameter: 2 inches Type of screen: sch 80

Screen slot size: 6 inches Setting depth: From 0 feet to 55 feet

Type of completion (circle all applicable): Gravel packed Underreamed Telescoped Open hole Natural Development  
SOFT CASING 5 FT SCREEN

Other (describe): \_\_\_\_\_

Top of lap pipe or reduction in casing: \_\_\_\_\_ feet. *If telescoped or more than one screen, describe on next page*


Form: OLWR-SWR-1A

*No Pump installed!*

RECEIVED  
 MAR 13 2007  
 BY: OLWR


The sketch below only required for water wells

If well telescopes, show depths on sketch.

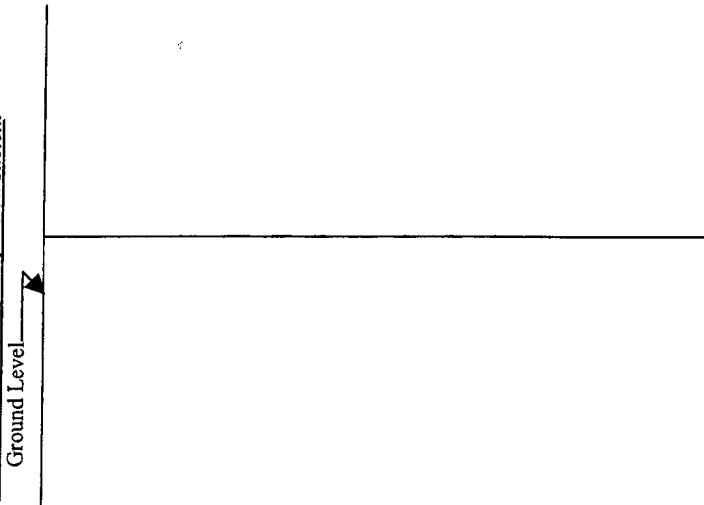

If more than one screen, show location of each on sketch

Sketch the property layout and include the following: 1) the well location; 2) any permanent structures on the property that may aid in locating the well; 3) any roads, power lines, or other items that may aid in locating the property and the well; 4) a north arrow.

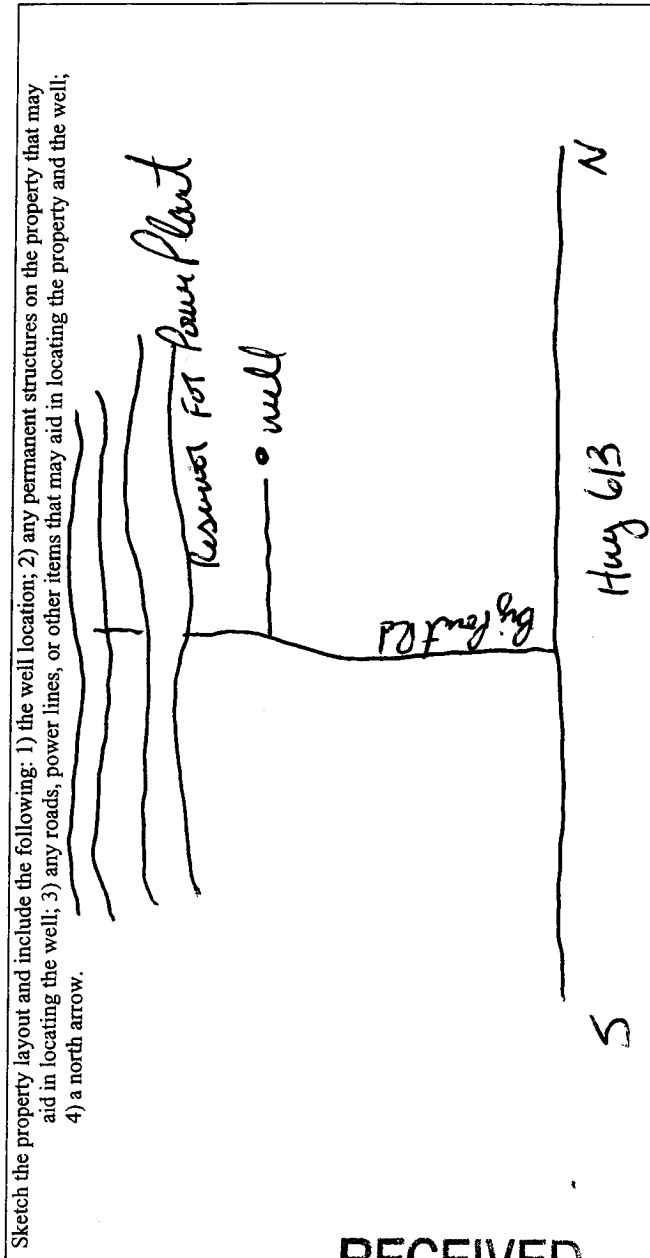

Description of formations encountered must be provided for all wells and boreholes, unless specifically exempted by regulations

Description of Formations Encountered	From (depth)		To (depth)	
	Ground Level		Ground Level	
Milk sand	0		55	

RECEIVED  
MAR 13 2007  
BY: OLWR

H-134