1	State Well Report	
County: Declard	Part 1 – Driller's Log	For Office Use Only:
Permit #: 0-780	Mississippi Department of Environmental Quality Office of Land and Water Resources	Aquifer:
Driller: W. Joel Presc	P.O. Box 10631	Well#: <u>H-154</u>
Date drilling completed: 118-68	Jackson, MS 39289-0631 (601)961-5210	L. S. Elevation:
	(601)354-6938 (fax)	E-log #:


с,

í

State Law requires that this report be prepared by the license holder responsible for the work and filed with the Department, at the above address within 20 d			
The second and the above address within 50 days of comi	pletion of drilling of the well or borehole.		
	Well or Borehole Location		
(Landowner if borehole is not for a water well)	2 89 . 79 . I . A		
Owner Name 1011 Jenney	Latitude: 88 • 29 1619 " Longitude: 30 • 37 146 "		
	Method of Lat/Long (circle one): Conventional Survey,		
Mailing Address: MUR lider Sub			
D	USGS quad, Hand-held GPS, Survey-grade GPS		
	1E 1/1W 1/2 Sec_ 8 Twn 55 Rng 5W		
Herely MD 39562	10 % 100 % Sec IWn_0 Rng		
City U State Zip Code	Distance Direction Nearest Town		
Telephone No. (208) 218 - 0654	Distance Direction Nearest Jown <u>3</u> Miles <b>Journ</b> of Hunly up		
$\partial (\partial (\partial$	0		
Well / Bore	hole Data		
Date drilling started: $1-18-08$ Date drilling completed: $1-18-08$	B Hole depth: <u>19</u> Hole diameter: <u>4</u>		
Location of the source of any surface water used for drilling	reiser un		
Location of the source of any surface water used for drilling:	opment: 4 gal Cherry 2000 (1 ale		
	· · · · · · · · · · · · · · · · · · ·		
Logs run (circle all applicable): No log run Electric Gamma Ray	Density Sonic Neutron Other:		
Name of organization running log(8)			
Purpose of borehole (check one): Water WellGeotechnical/Geole	ogical Investigation Ground Source Heat Pump		
Seismic Survey Other (describe	)		
If drilling is not related to water well construction	n, skip the remainder of this block		
Purpose of Well (check one): HomeIndustrial Public Supply	IrrigationFish CultureOther:		
If a flowing well, method of flow regulation: Valve O	ther (describe)		
Static Water Level:feet above or below (circle one) I	and surface Date measured: $1 - 18 - 08$		
Method of Measurement (circle one) steel tape electric tape (air line) other:			
Well depth: Kell grouted to a depth of 10 feet Type of grout (circle one): Neat Cement Bentonite Mix			
Casing length: <u>65</u> feet Casing diameter: <u>4</u> inches Type of casing: <u>20140 Plostu</u>			
Screen length: <u>10</u> feet Screen diameter: <u>4</u> inches Type of screen: <u>Sch 80 11</u>			
Screen length: 70 reet Screen diameter: 7	_inches lype of screen:		
Screen slot size: inches Setting depth: From	0 feet to <u>75</u> feet		
Screen slot size: inches Setting depth: From	10 quen 65 caling		
Type of completion (circle all applicable): Gravel packed Under	reamed Telescoped Open hole Natural Development		
Other (describe):			
Ton of lon nine or reduction in coning.	to an interest the second second the an year		
Top of lap pipe or reduction in casing:feet. If tel	iescopea or more than one screen, describe on next page		

Form: OLWR-SWR-1A

H-154

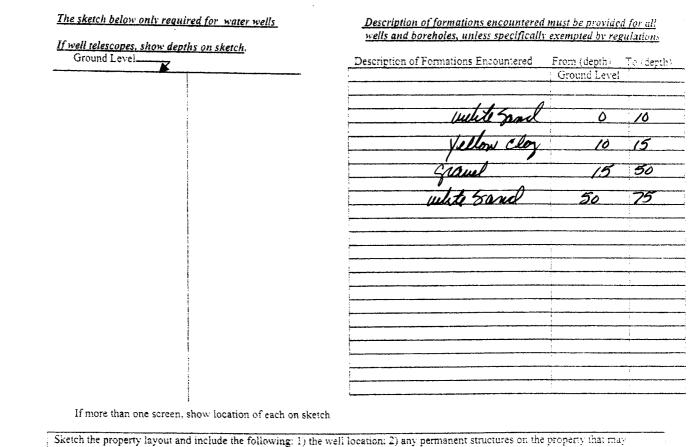

aid in locating the well; 3) any roads, power lines, or other items that may aid in locating the property and the well;

4) a north arrow. mel Tory Landowner Name: \_ う Form: OLWR-SWR-1A I certify that the well/borehole was drilled, constructed, and completed in accordance with all applicable requirements of the Mississippi Department of Environmental Quality and the Mississippi Department of Health regulations, if applicable, and state laws 0-780 - 18-08 YOM 0E Signature of Licensee Print Name of Responsible Licensee and License No. Date

Date completed: $1 - 18 - 0.8$ (601)961-5210	For Office Use Only:    Lquifer:

з.

=

This part of the report must be completed by a licensed water well contractor or a licensed pump installer. A copy of Part 1 of the report must be attached and both parts filed with the Department at the above address within 30 days of well completion. Well Owner Information Well Location

Well Owner Information	Wen Location
Owner Name: Tory Lerry	Latitude: 88-29-619 Longitude: 30-37-436
Mailing Address: land luckey Sub	Method of Lat/Long (check one): Conventional Survey
	USGS quad Hand-held GPS , Survey-grade GPS
tuly us 39457	NE 1/ MW 1/ Sec. 8 155 R 54
City U State Zip Code	Distance Direction Nearest Town
Telephone No. (208) 2-18 -0654	3 Miles South of Hully, no

	Pump Type Circle one			Power Type Circle one	
Air Lift	Jet	Submersible	Diesel Engine	Gasoline Engine	Natural Gas
Bucket	Piston	Turbine	Electric Motor	Hand	Tractor PTO
Centrifugal	Rotary	Flowing Well	Windmill	Other (specify):	
Other (specify):			Horse Power Rating	g of Motor:	
Date Pump Installed:	1-18-08		Setting Depth:	40 deop Pipe	feet
Rated Pump Capacity:	20	Gallons Per Minute	Number of Stages:	01	

Pump Test Data	Method of Measuring Water Level Circle one		
Date Well Tested: <u>1-18-68</u> Static Water Level (A): <u>3</u> Feet Below Land Surface	Air Line Electric Measuring Line Steel Tape Other (specify):		
Pumping Water Level (B): <u>40</u> Feet Below Land Surface			
Drawdown $[(B) - (A)]$ :Feet Below Land Surface	For flowing well, measured shut in head:fect		
Test Pumping Rate: <u>20</u> Gallons Per Minute	Well yielded GPM with a drawdown of		
Duration of Pump Test (minimum 4 hours): <u>48</u> hours			
I HEREBY CERTIFY that the above statements are true to the best of my knowledge.			
Print Name of Pump Installer and License No. (if applicable)	Signature of Pump Installer		

Form: OLWR-SWR-1B