

State Well Report

Part 1

Mississippi Department of Environmental Quality
Office of Land and Water Resources
P.O. Box 10631
Jackson, MS 39289-0631
(601) 961-5210
(601) 354-6938 (fax)

For Office Use Only:

Aquifer: _____
Well #: H-164
L. S. Elevation: _____
E-log #: _____

County: Jackson
Permit #: _____
Driller: Coast Water Wells SA, Inc.
Date drilling completed: 4-23-08

State Law requires that this report be prepared by the driller in detail and filed with the Department within 30 days of completion of drilling of the well.

| Well Owner Information | Well Location |
|--|---|
| Owner Name: <u>Clinton + Linda Almond</u> | Latitude: <u>30° 35' 18.3"</u> Longitude: <u>88° 27' 35.15"</u> |
| Mailing Address: <u>Rayford Shumock AD</u> | Method of Lat/Long (circle one): <u>Hand-held GPS</u> Conventional Survey, Survey-grade GPS |
| <u>Miss Point, MS 39562</u> | USGS quad, <u>SE 1/4 SE 1/4 Sec 23 Twn T5S Rng R5W</u> |
| City: _____ State: _____ Zip Code: _____ | Distance: <u>2 1/2</u> Miles Direction: <u>NE</u> of Nearest Town: <u>Big Point</u> |
| Telephone No. <u>601 588-3123</u> | |

Well Data

Purpose of Well (circle one): Home Industrial Public Supply Irrigation Fish Culture Other: _____

Date well drilling started: 4-22-08 Date well drilling completed: 4-23-08

If flowing, method of flow regulation: Valve N/A Other (describe) _____

Static Water Level: +5 feet above or below (circle one) land surface Date measured: 4-23-08

Method of Measurement (circle one): steel tape electric tape air line other: _____

Hole depth: 395 FT Well depth: 395 FT Well grouted to a depth of 10 feet

Type of grout (circle one): Cement Bentonite Mix

Casing length: 385 feet Casing diameter: 2 inches Type of casing: PVC

Screen length: 10 feet Screen diameter: 2 inches Type of screen: PVC

Screen slot size: .006 inches Setting depth: From 385 feet to 395 feet

Type of completion (circle all applicable): Gravel packed Underreamed Telescoped Open hole Natural Development

Other (describe): _____

Top of lap pipe or reduction in casing: N/A feet. If telescoped or more than one screen, describe on back of page

Logs run (circle all applicable): No log run Electric Gamma Ray Density Sonic Neutron Other: _____

Name of organization running log(s): N/A

I certify that the well was drilled, constructed, and completed in accordance with all applicable requirements of the Mississippi Department of Environmental Quality and/or the Mississippi Department of Health regulations and state laws.


Jack Ridgdell 0-472 _____
Print Name of Water Well Contractor and License No. Signature of Water Well Contractor

RECEIVED
MAY 14 2008
BY: OLWR

H-164

If well telescopes please sketch below and show depths.

Ground Level

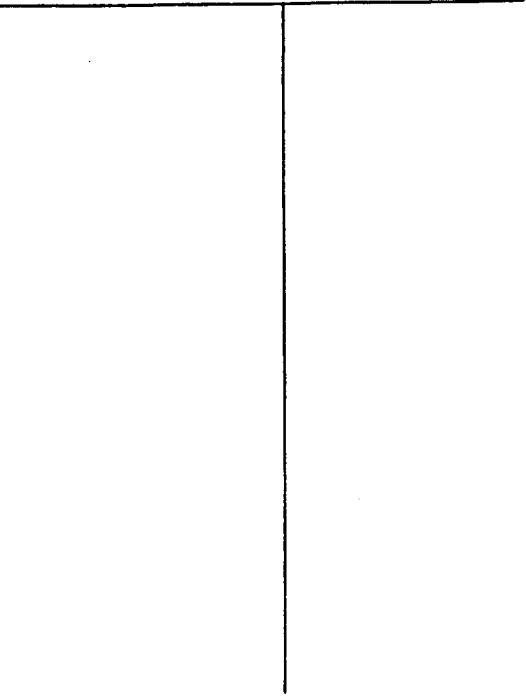

| Description of Formations Encountered | From | To |
|---------------------------------------|------|-----|
| Top Soil | 0 | 2 |
| Blue Clay | 2 | 12 |
| White coarse sand | 12 | 110 |
| Blue Clay w/ streaks of sand | 110 | 378 |
| Gray Coarse Sand | 378 | 395 |
| | | |
| | | |
If more than one screen, show location of each on sketch

Sketch the property layout and include the following: 1) the well location; 2) any permanent structures on the property that may aid in locating the well; 3) any roads, power lines, or other items that may aid in locating the property and the well; 4) indicate direction.

Landowner Name: Clint & Linda Almond

Jack Ritzdell
 Signature of Water Well Contractor

RECEIVED
 MAY 14 2008
 BY: OLWR

STATE WELL REPORT

Part 2

Pump Installer's Completion Report
 Mississippi Department of Environmental Quality
 Office of Land and Water Resources
 P.O. Box 10631
 Jackson, MS 39289-0631
 (601)961-5210
 (601)354-6938 (fax)

For Office Use Only:

Aquifer: _____

Well #: H-169

Elevation: _____

County: Jackson

Permit #: _____

Driller: Coastwater wellsrv.

Date completed: 4-23-08

This report should be prepared by the pump installer in detail and filed with the Department within 30 days of the installation of pump.

| Well Owner Information | Well Location |
|---|---|
| Owner Name: <u>Clint + Linda Almond</u> | Latitude: <u>30° 35' 683"</u> Longitude: <u>088° 27' 258"</u> |
| Mailing Address: <u>Rayford Shumock Rd.</u> | Method of Lat/Long (circle one): Conventional Survey, USGS quad, <u>Hand-held GPS</u> , Survey-grade GPS |
| <u>Miss Point Ms 39562</u> City State Zip Code | <u>SE 1/4 SE 1/4 Sec 23 Twn T55 Rng R5 W</u> |
| Telephone No. <u>228) 588-3123</u> | Distance Direction Nearest Town <u>2 1/2 Miles NE of Big Point</u> |

| Pump Type Circle one | Power Type Circle one |
|---|--|
| Air Lift <input type="radio"/> Jet <input checked="" type="radio"/> Submersible | Diesel Engine Gasoline Engine Natural Gas |
| Bucket <input type="radio"/> Piston <input type="radio"/> Turbine | <input checked="" type="radio"/> Electric Motor <input type="radio"/> Hand <input type="radio"/> Tractor PTO |
| Centrifugal <input type="radio"/> Rotary <input type="radio"/> Flowing Well | Windmill Other (specify): _____ |
| Other (specify): _____ | Horse Power Rating of Motor: <u>1/2 HP</u> |
| Date Pump Installed: <u>4-25-08</u> | Setting Depth: <u>20 FT. Drop pipe</u> feet |
| Rated Pump Capacity: <u>8.5</u> Gallons Per Minute | Number of Stages: <u>1</u> |

| Pump Test Data | Method of Measuring Water Level Circle one |
|---|--|
| Date Well Tested: <u>4-25-08</u> | <input checked="" type="radio"/> Air Line <input type="radio"/> Electric Measuring Line <input type="radio"/> Steel Tape |
| Static Water Level (A): <u>+5</u> Feet Below Land Surface | Other (specify): _____ |
| Pumping Water Level (B): <u>+5</u> Feet Below Land Surface | For flowing well, measured shut in head: <u>+5</u> feet |
| Drawdown [(B) - (A)]: <u>N/A</u> Feet Below Land Surface | Well yielded <u>36</u> GPM with a drawdown of <u>N/A</u> feet after <u>N/A</u> hours of pumping |
| Test Pumping Rate: <u>8.5</u> Gallons Per Minute | |
| Duration of Pump Test (minimum 4 hours): <u>4 1/2</u> hours | |

I HEREBY CERTIFY that the above statements are true to the best of my knowledge.

Jack Ridgell 0-472
 Print Name of Pump Installer and License No. (if applicable)

Jack Ridgell
 Signature of Pump Installer

RECEIVED

MAY 14 2008
 BY: OLWR