

State Well Report

Part 1

Mississippi Department of Environmental Quality
Office of Land and Water Resources
P.O. Box 10631
Jackson, MS 39289-0631
(601) 961-5210
(601) 354-6938 (fax)

For Office Use Only:

Aquifer: _____
Well #: 4214
L. S. Elevation: _____
E-log #: _____

County: Jackson
Permit #: _____
Driller: Coast Water Wells Serv
Date drilling completed: 3/29/12

State Law requires that this report be prepared by the driller in detail and filed with the Department within 30 days of completion of drilling of the well.

Well Owner Information	Well Location
Owner Name: <u>Robert Peden</u>	Latitude: <u>30.35.30.0</u> Longitude: <u>088.27.3384</u>
Mailing Address: <u>19815 Rayford Shumack Rd</u>	Method of Lat/Long (circle one): <u>30</u> Conventional Survey, <u>34</u>
<u>Miss Point, MS 39562</u>	USGS quad, <u>(Hand-held GPS)</u> Survey-grade GPS
City: _____ State: _____ Zip Code: _____	<u>SW 1/4 Sec 23</u> Twn <u>T5S</u> Rng <u>R5W</u>
Telephone No. <u>251.776-0964</u>	Distance: <u>1 1/4</u> Miles Direction: <u>NE</u> of Nearest Town: <u>Big Point</u>

Well Data

Purpose of Well (circle one): Home Industrial Public Supply Irrigation Fish Culture Other: _____

Date well drilling started: 3/29/12 Date well drilling completed: 3/29/12

If flowing, method of flow regulation: Valve N/A Other (describe) _____

Static Water Level: 1 feet above or below (circle one) land surface Date measured: 3/29/12

Method of Measurement (circle one): steel tape electric tape air line other: _____

Hole depth: 448 FT Well depth: 448 FT Well grouted to a depth of 10 feet

Type of grout (circle one): Cement Bentonite Mix

Casing length: 438 feet Casing diameter: 2 inches Type of casing: PVC

Screen length: 10 feet Screen diameter: 2 inches Type of screen: PVC

Screen slot size: .006 inches Setting depth: From 438 feet to 448 feet

Type of completion (circle all applicable): Gravel packed Underreamed Telescoped Open hole Natural Development

Other (describe): _____

Top of lap pipe or reduction in casing: N/A feet. If telescoped or more than one screen, describe on back of page

Logs run (circle all applicable): No log run Electric Gamma Ray Density Sonic Neutron Other: _____

Name of organization running log(s): N/A

I certify that the well was drilled, constructed, and completed in accordance with all applicable requirements of the Mississippi Department of Environmental Quality and/or the Mississippi Department of Health regulations and state laws.

Jack Ridgell 0-472
Print Name of Water Well Contractor and License No.

[Signature]
Signature of Water Well Contractor

RECEIVED


If well telescopes please sketch below and show depths.

Ground Level

Description of Formations Encountered	From	To
Top Soil	0	2
White Clay	2	10
White Coarse Sand w/ streaks of clay	10	90
Blue Clay	90	140
Gray Coarse Sand	140	160
Blue Clay	160	426
Gray Medium to Coarse Sand	426	448

If more than one screen, show location of each on sketch

Sketch the property layout and include the following: 1) the well location; 2) any permanent structures on the property that may aid in locating the well; 3) any roads, power lines, or other items that may aid in locating the property and the well; 4) indicate direction.

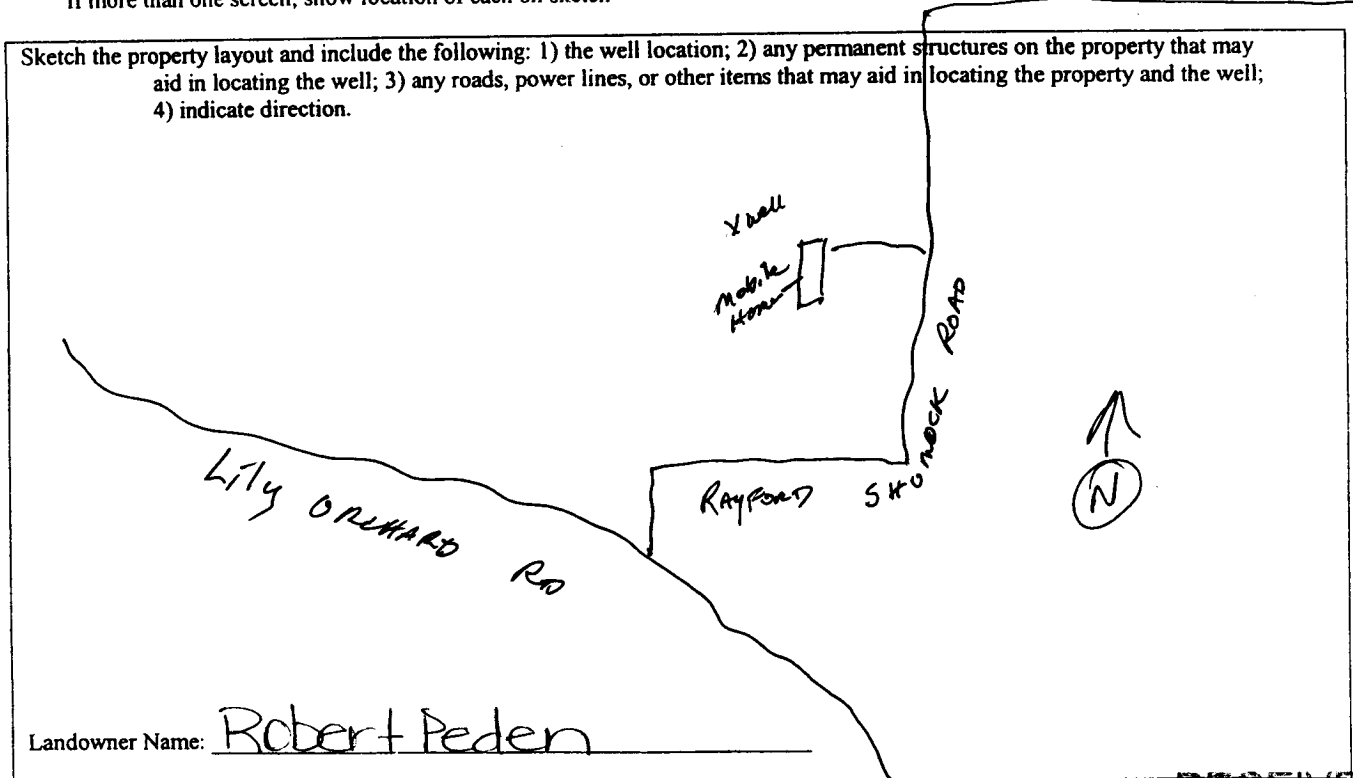

Landowner Name: Robert Peden

Jan Rydzewski
 Signature of Water Well Contractor

RECEIVED
 APR 13 2012
 BY: OLWR
 Lewis Printing - Pascagoula, MS

STATE WELL REPORT

Part 2

Pump Installer's Completion Report
 Mississippi Department of Environmental Quality
 Office of Land and Water Resources
 P.O. Box 10631
 Jackson, MS 39289-0631
 (601) 961-5210
 (601) 354-6938 (fax)

For Office Use Only:

Aquifer: H 214
 Well #: _____
 Elevation: _____

County: Jackson
 Permit #: _____
 Driller: Coast Water Wells Serv.
 Date completed: 3/29/12

This report should be prepared by the pump installer in detail and filed with the Department within 30 days of the installation of pump.

Well Owner Information	Well Location
Owner Name: <u>Robert Federn</u>	Latitude: <u>30° 35' 30.30"</u> Longitude: <u>088° 27' 33.84"</u>
Mailing Address: <u>19815 Rayford Shumack Rd</u>	Method of Lat/Long (circle one): Conventional Survey, USGS quad, <u>Hand-held GPS</u> , Survey-grade GPS
<u>Moss Point, MS 39562</u> City State Zip Code	<u>SW 1/4 SW 1/4 Sec 23 Twn 75S Rng R5W</u>
Telephone No. <u>251-776-0964</u>	Distance Direction Nearest Town <u>1 1/4</u> Miles <u>NE</u> of <u>Big Point</u>

Pump Type Circle one	Power Type Circle one
Air Lift <input type="radio"/> <u>Jet</u> <input type="radio"/> Submersible	Diesel Engine <input type="radio"/> Gasoline Engine <input type="radio"/> Natural Gas
Bucket <input type="radio"/> Piston <input type="radio"/> Turbine	<u>Electric Motor</u> <input type="radio"/> Hand <input type="radio"/> Tractor PTO
Centrifugal <input type="radio"/> Rotary <input type="radio"/> Flowing Well	Windmill <input type="radio"/> Other (specify): _____
Other (specify): _____	Horse Power Rating of Motor: <u>3/4 H.P.</u>
Date Pump Installed: <u>4/11/12</u>	Setting Depth <u>20 FT Drop Pipe</u> feet
Rated Pump Capacity: <u>10</u> Gallons Per Minute	Number of Stages: <u>1</u>

Pump Test Data	Method of Measuring Water Level Circle one
Date Well Tested: <u>4/11/12</u>	<u>Air Line</u> <input type="radio"/> Electric Measuring Line <input type="radio"/> Steel Tape <input type="radio"/>
Static Water Level (A): <u>1</u> Feet Below Land Surface	Other (specify): _____
Pumping Water Level (B): <u>N/A</u> Feet Below Land Surface	For flowing well, measured shut in head: <u>N/A</u> feet
Drawdown [(B) - (A)]: <u>N/A</u> Feet Below Land Surface	Well yielded <u>30</u> GPM with a drawdown of
Test Pumping Rate: <u>10</u> Gallons Per Minute	<u>N/A</u> feet after <u>N/A</u> hours of pumping
Duration of Pump Test (minimum 4 hours): <u>4</u> hours	

I HEREBY CERTIFY that the above statements are true to the best of my knowledge.

Jack Ridadell 0-472 Jack Ridadell RECEIVED
 Print Name of Pump Installer and License No. (if applicable) Signature of Pump Installer