

State Well Report

Part 1

Mississippi Department of Environmental Quality
Office of Land and Water Resources
P.O. Box 10631
Jackson, MS 39289-0631
(601)961-5210
(601)354-6938 (fax)

County: Jackson
 Permit #: _____
 Driller: Coast Water Well Srv
 Date drilling completed: 9-8-04

For Office Use Only:

Aquifer: _____
 Well #: M-417 059
 L. S. Elevation: H 222
 E-log #: _____

State Law requires that this report be prepared by the driller in detail and filed with the Department within 30 days of completion of drilling of the well.

Well Owner Information	Well Location
Owner Name: <u>Bobby Welch</u>	Latitude: <u>30° 33' 27"</u> Longitude: <u>088° 24' 53"</u>
Mailing Address: <u>Deer Creek Rd.</u>	Method of Lat/Long (circle one): <u>Conventional Survey</u>
<u>MOSS POINT MS 39563</u>	USGS quad, <u>(Hand-held GPS)</u> Survey-grade GPS
City: _____ State: _____ Zip Code: _____	<u>NE 1/4 SW 1/4 Sec 5 Twn 96S Rng R4W</u>
Telephone No. <u>228 474-1209</u>	Distance: <u>6</u> Miles Direction: <u>NE</u> of Nearest Town: <u>Heleva</u>

Well Data

Purpose of Well (circle one): Home Industrial Public Supply Irrigation Fish Culture Other: _____

Date well drilling started: 9-8-04 Date well drilling completed: 9-8-04

If flowing, method of flow regulation: Valve N/A Other (describe) _____

Static Water Level: 40 feet above or below (circle one) land surface Date measured: 9-8-04

Method of Measurement (circle one): steel tape electric tape air line other: _____

Hole depth: 100' Well depth: 100' Well grouted to a depth of 10 feet

Type of grout (circle one): Cement Bentonite Mix

Casing length: 90 feet Casing diameter: 2 inches Type of casing: PVC

Screen length: 10 feet Screen diameter: 2 inches Type of screen: PVC

Screen slot size: .008 inches Setting depth: From 90 feet to 100 feet

Type of completion (circle all applicable): Gravel packed Underreamed Telescoped Open hole Natural Development

Other (describe): _____

Top of lap pipe or reduction in casing: N/A feet. If telescoped or more than one screen, describe on back of page

Logs run (circle all applicable): No log run Electric Gamma Ray Density Sonic Neutron Other: _____

Name of organization running log(s): N/A

RECEIVED
SEP 16 2004
BY: OLWR

I certify that the well was drilled, constructed, and completed in accordance with all applicable requirements of the Mississippi Department of Environmental Quality and/or the Mississippi Department of Health regulations and state laws.

Jack Ridgell 0-472 _____
 Print Name of Water Well Contractor and License No. Signature of Water Well Contractor

~~M-417~~

H222


If well telescopes please sketch below and show depths.

Ground Level

Description of Formations Encountered	From	To
Top Soil	0	2
Orange Clay	2	20
Brown Coarse Sand	20	80
White Clay	80	85
Brown Coarse Sand	85	100

If more than one screen, show location of each on sketch

Sketch the property layout and include the following: 1) the well location; 2) any permanent structures on the property that may aid in locating the well; 3) any roads, power lines, or other items that may aid in locating the property and the well; 4) indicate direction.

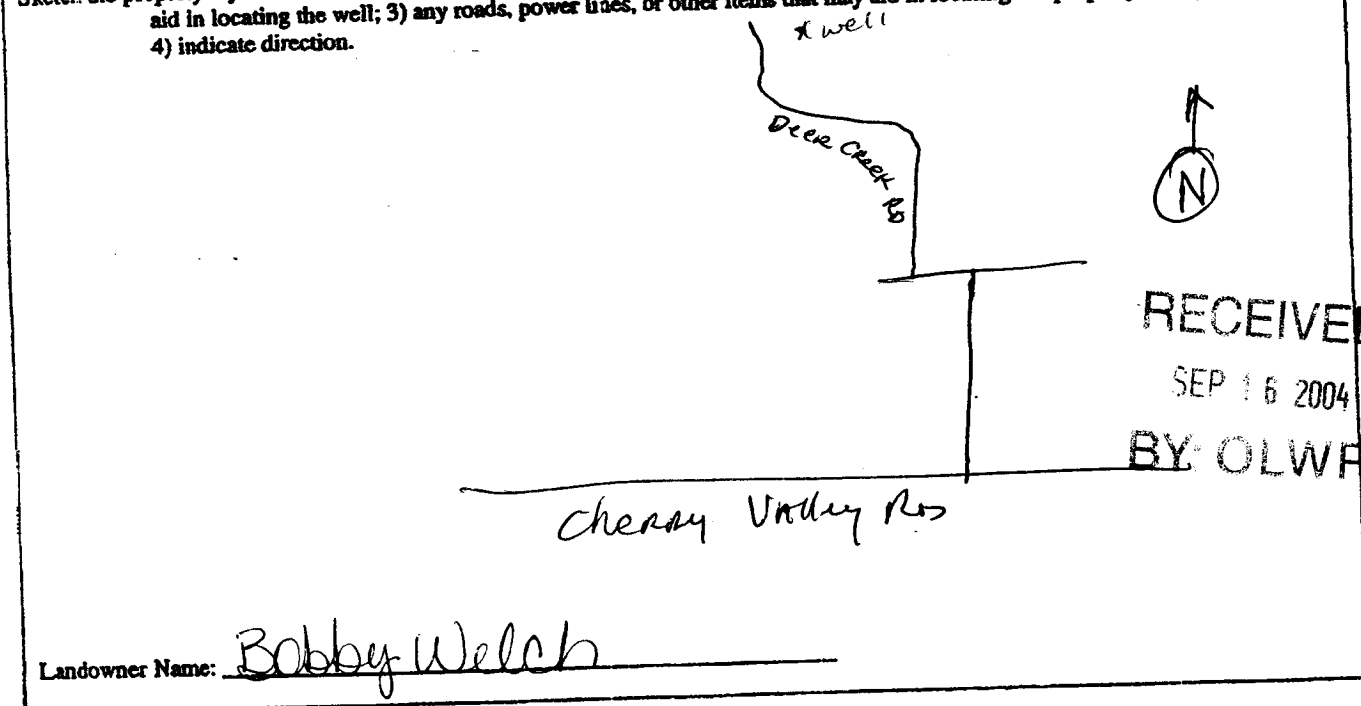

RECEIVED
SEP 16 2004
BY: OLWR

Landowner Name: Bobby Welch

Jack Riddick
Signature of Water Well Contractor

STATE WELL REPORT

Part 2

Pump Installer's Completion Report
 Mississippi Department of Environmental Quality
 Office of Land and Water Resources
 P.O. Box 10631
 Jackson, MS 39289-0631
 (601)961-5210
 (601)354-6938 (fax)

For Office Use Only:

Aquifer: _____

Well #: 11-417

Elevation: 422

County: Jackson
 Permit #: _____
 Driller: Coast Water Well Service
 Date completed: 9-8-04

This report should be prepared by the pump installer in detail and filed with the Department within 30 days of the installation of pump.


Well Owner Information	Well Location
Owner Name: <u>Bobby Welch</u>	Latitude: <u>30°33'.877"</u> Longitude: <u>088°24'.534"</u>
Mailing Address: <u>Deer Creek Rd</u>	Method of Lat/Long (circle one): Conventional Survey,
<u>Mass Point MS 39563</u>	USGS quad, <u>(Hand-held GPS)</u> Survey-grade GPS
City State Zip Code	<u>NE 1/4 SW 1/4 Sec 5 Twn 6S Rng 4W</u>
Telephone No. <u>(228)474-1209</u>	<u>12</u> Miles <u>NE</u> of <u>Mass Point</u>

Pump Type Circle one	Power Type Circle one
Air Lift <input type="radio"/> Jet <input checked="" type="radio"/> Submersible	Diesel Engine Gasoline Engine Natural Gas
Bucket <input type="radio"/> Piston <input type="radio"/> Turbine	<input checked="" type="radio"/> Electric Motor <input type="radio"/> Hand <input type="radio"/> Tractor PTO
Centrifugal <input type="radio"/> Rotary <input type="radio"/> Flowing Well	Windmill Other (specify): _____
Other (specify): <u>1 H.P. Sta-Rite</u>	Horse Power Rating of Motor: <u>1 H.P.</u>
Date Pump Installed: <u>10-20-04</u>	Setting Depth: <u>Drop pipe 80</u> feet
Rated Pump Capacity: <u>8</u> Gallons Per Minute	Number of Stages: <u>2</u>

Pump Test Data	Method of Measuring Water Level Circle one
Date Well Tested: <u>10-20-04</u>	<input checked="" type="radio"/> Air Line <input type="radio"/> Electric Measuring Line <input type="radio"/> Steel Tape
Static Water Level (A): <u>40</u> Feet Below Land Surface	Other (specify): _____
Pumping Water Level (B): <u>N/A</u> Feet Below Land Surface	For flowing well, measured shut in head: <u>N/A</u> feet
Drawdown [(B) - (A)]: <u>N/A</u> Feet Below Land Surface	Well yielded _____ GPM with a drawdown of _____
Test Pumping Rate: <u>8</u> Gallons Per Minute	_____ feet after _____ hours of pumping
Duration of Pump Test (minimum 4 hours): <u>6</u> hours	

I HEREBY CERTIFY that the above statements are true to the best of my knowledge.

Johnny EIKINS 0-716P
 Print Name of Pump Installer and License No. (if applicable)

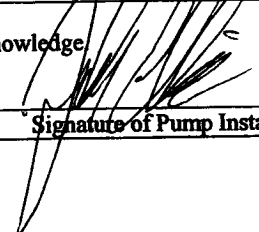
 Signature of Pump Installer

RECEIVED

NOV 01 2004
 BY: OLWR