STATE WELL REPORT						
County: Jackson	Part 1 Driller's Log Mississippi Department of Environmental Quality		For Office Use	Only:		
Permit #: Driller: Michael Fryfogle	Office of Land and Water Resources P.O. Box 2309		Aquifer:			
Date drilling completed: 08/17/2021	Jackson, MS 39225-2309 (601)961-5555		E-Log #:	RECEIVED		
	. (60	1)961-5228 (fax)		09-10-2021		
State Law requires that this report be prepared by the license holder responsible for the work and filed with the Department at the above address within 30 days of completion of drilling of the well or borehole.						
Well Owner Informat (Landowner if borehole is not for			hole Location			
Owner Name: Dusty Watts	a water well)	Latitude: 30.6330550 Longitude: -88.4624890		4890		
): Conventional Surve	ey,		
		USGS quad, Hand-held G	PS <u>/</u> , Survey-grade	GPS		
Moss point Ms	39562	<u>SW</u> 1/4 <u>SW</u> 1/4, Sec		<u>,5W</u>		
City State	Zip Code	2.34 Miles SE o	_f Hurley			
Telephone No. ()		(Distance) (Direction)	(Nearest Tow	n)		
		orehole Data				
Date drilling started: 08/17/2021 Date			Hole diameter:	4 1/2		
Location of the source of any surface water used for drilling: None						
Method of dosing and volume of Chlori	ne used in drilling a	nd development:				
Logs run (check all applicable): No log r	un Electric Gamı	ma Ray Density Sonic Neutro	on Other:			
Name of organization running log(s):						
Purpose of borehole (check one): Water	Well 🗹 Geotechn	ical/Geological Investigation	Ground Source Heat Pu	Imp		
		(describe)				
If drilling is not rel	ated to water well c	onstruction, skip the remainder	of this block			
Purpose of Well (check all applicable): Home Industrial Public Supply Irrigation Fish Culture						
Other (describe):						
If a flowing well, method of flow regulation: Valve Other (<i>describe</i>)						
Static Water Level: <u>30</u> feet [above or below] land surface Date measured: <u>08/17/2021</u> (check one)						
Method of measurement (check one):		•				
Well depth: <u>180</u> Well grouted to a				nite Mix		
		inches Type of c				
Screen length: <u>10</u> feet Screen diameter: <u>2</u> inches Type of screen: <u>Wrap</u>						
Screen slot size: <u>.06</u> inches Setting depth: From <u>170</u> feet to <u>180</u> feet						
Type of completion (check all applicable): Gravel packed Underreamed Open hole Natural Development						
Other (describe):						
Top of lap pipe or reduction in casing:feet						
If telescoped or more than one screen, describe on next page						

County:	Jackson	1
Permit #:	·	

If well telescopes, show depths on sketch.

×

Ground Level

RECEIVED 09-10-2021 **BY OLWR**

For Office Use Only:

Well #: <u>H273</u>

<u>Description of formations encountered must be provided for all wells</u> and boreholes, unless specifically exempted by regulations

Description of Formations Encountered	From (<i>depth</i>) Ground level	To (depth)
	Ground level	
Sand	0	32
Clay blue	32	165
Sand	165	180

If more than one screen, show location of each on sketch


Sketch the property layout and include the following:

1) the well location

2) any permanent structures on the property that may aid in locating the well

3) any roads, power lines, or other items that may aid in locating the property and the well

4) north arrow

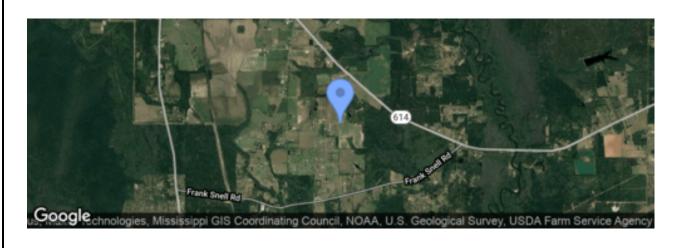

Landowner Name: Dusty Watts

I HEREBY CERTIFY that the well/borehole was drilled, constructed, and completed in accordance with all applicable requirements of the Mississippi Department of Environmental Quality and the Mississippi Department of Health regulations, if applicable, and state laws.

Michael Fryfogle 0408 Print Name of Responsible Licensee and License No. 09/03/2021 Date



Michael Fryfogle Signature of Licensee

BYÖLWF

The sketch below only required for water wells and boreho