

Jackson  
H 2880  
12-10-75

MISSISSIPPI  
BOARD OF WATER COMMISSIONERS  
416 North State Street  
Jackson, Mississippi 39201

WATER WELL DRILLERS LOG

Dec 10 1975 date well completed  
Riffin Well Co firm name  
Jackson county well located

LANDOWNER: Mike Long  
RR 2

description of formations encountered  
from to

Pascagoula River  
(mailing address)

red clay sand 0' 21'

WELL LOCATION:  
sec 28 T 1 N R 5 E S  
W 1/2

Base sand muddy 2' 30'

In Big Point of  
(distance) (direction) (nearest town)

white sand clay  
up sand bit with 30' 45'

WELL PURPOSE: Home  
(home, irrigation, municipal, industrial)

white + yellow clay 55' 20'

WELL COMPLETION DATA:

med coarse white sand 20' 85'

(1) diameter (inches) 2"

(2) total depth (feet) 85'

(3) static water level (feet) 8' below top of ground.

(4) casing PVC 80' (material) (depth)

(size) If telescope see back.

(5) screen 15' 20' (length) (depth to top)

2" PVC (size) (material)

(6) pump 1/2 (HP) 12 (yield gpm)

el. (type power)

(7) electric log no (yes or no)

(organization running log)


(8) how well bottom plugged B.W.C.

DRILLERS REMARKS:

RECEIVED  
JAN 8 1976  
MISS. Bd. of Water Comm.

If well telescopes please sketch and show depths.

GROUND LEVEL

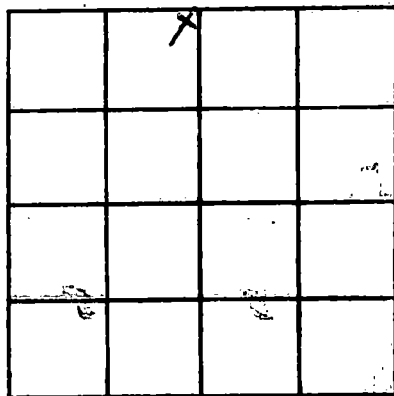

SECTION 38

Please indicate well location X.

ADDITIONAL INFORMATION

If more than one screen,  
show locations of each on sketch.