

JACKSON
H 2001
2-3-76

MISSISSIPPI
BOARD OF WATER COMMISSIONERS
416 North State Street
Jackson, Mississippi 39201

WATER WELL DRILLERS LOG
COASTAL DRILLING & SERVICE CO.

2/3/76
date well completed

ROUTE 1 BOX 618
firm name
BILOXI, MISS 39532

Jackson
county well located

LANDOWNER: Bill Johnson

pt 6
mass point min
(mailing address)

description of formations encountered	from	to
top soil	1	2
red clay	2	15
white sand	15	28
sugar sand	28	40
algae	40	55
white sand	55	80
soft blue clay	80	130
fine white sand	130	158
soft blue clay	150	170
hard blue clay	170	250
rock	250	255
fine white sand	255	270
coarse white sand	270	300

WELL LOCATION:
sec 10 T 5 N R 5 E
S W
Big Point
(distance) (direction) (nearest town)

WELL PURPOSE: home
(home, irrigation, municipal, industrial)


WELL COMPLETION DATA:

- (1) diameter (inches) 2"
- (2) total depth (feet) 300'
- (3) static water level (feet) 35 below above top of ground.
- (4) casing PVC, 290'
(material) (depth)
 If telescope see back.
(size)
- (5) screen 10', 290'
(length) (depth to top)
2", PVC
(size) (material)
- (6) pump one 14
(HP) (yield gpm)
ele
(type power)
- (7) electric log no
(yes or no)

(organization running log)

(8) how well bottom plugged
2" sand water valve


DRILLERS REMARKS:
none

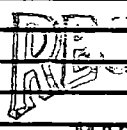

MAR 25 1976

If well telescopes please sketch and show depths.

GROUND LEVEL

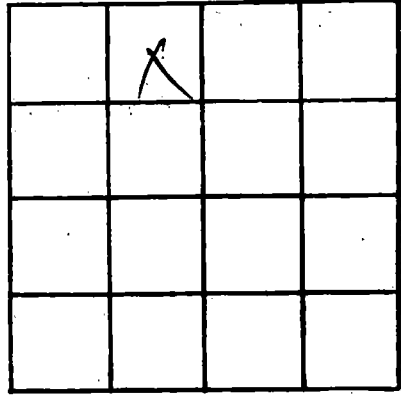

SECTION _____

Please indicate well location X.

ADDITIONAL INFORMATION

If more than one screen, show locations of each on sketch.