

JACKSON
H 2002
2-11-76

MISSISSIPPI
BOARD OF WATER COMMISSIONERS
416 North State Street
Jackson, Mississippi 39201

WATER WELL DRILLERS LOG

Feb 11 1976 ^{13R} Griffin Well Co Jackson
date well completed firm name county well located

LANDOWNER: John Rogers Rt 2	description of formations encountered	from	to
Pascagoula Miss (mailing address)	red sand	0'	2'
WELL LOCATION: sec. 2 T. 5 N. R. 4 E	white sand	2'	24'
4 miles East of Hualy (distance) (direction) (nearest town)	yellow & white clay	24'	56'
WELL PURPOSE: Home (home, irrigation, municipal, industrial)	light blue clay	56'	20'
WELL COMPLETION DATA: (1) diameter (inches) 2"	med coarse white sand	20'	88'
(2) total depth (feet) 80'			
(3) static water level (feet) 52' below top of ground			
(4) casing PVC, 80' (material) (depth)			
If telescope see back. (size)			
(5) screen 4' (length), 80' (depth to top)			
2" (size), PVC (material)			
(6) pump 1 (HP), 10 (yield gpm)			
ela (type power)			
(7) electric log no (yes or no)			
(organization running log)			
(8) how well bottom plugged Bw 4.			
DRILLERS REMARKS:			


OVER THE
FILE

APR 1 1976

MISS. BD. OF WA.

If well telescopes please sketch and show depths.

GROUND LEVEL

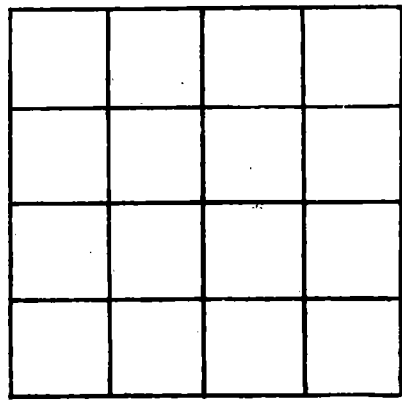

SECTION _____

Please indicate well location X.

ADDITIONAL INFORMATION

If more than one screen, show locations of each on sketch.